

SHEET INDEX	
NO	DESCRIPTION
1	TITLE SHEET
2	SITE DEVELOPMENT PLAN
3	DRAINAGE AREA MAP, GRADING AND SEDIMENT CONTROL PLAN
4	PROFILES AND DETAILS
5	SEDIMENT CONTROL NOTES AND DETAILS
6	SWM PROFILES AND DETAILS
7	WATER QUALITY NOTES AND DETAILS
8	LANDSCAPING PLAN

GENERAL NOTES

- ALL CONSTRUCTION SHALL BE IN ACCORDANCE WITH THE LATEST STANDARDS AND SPECIFICATIONS OF HOWARD COUNTY PLUS MSHA STANDARDS AND SPECIFICATIONS, IF APPLICABLE.
- THE CONTRACTOR SHALL NOTIFY THE DEPARTMENT OF PUBLIC WORKS/BUREAU OF ENGINEERING/ CONSTRUCTION INSPECTION DIVISION AT (410) 313-1880 AT LEAST FIVE (5) WORKING DAYS PRIOR TO THE START OF WORK.
- THE CONTRACTOR SHALL NOTIFY "MISS UTILITY" AT 1-800-257-7777 AT LEAST 48 HOURS PRIOR TO ANY EXCAVATION WORK BEING DONE.
- TRAFFIC CONTROL DEVICES, MARKINGS, AND SIGNING SHALL BE IN ACCORDANCE WITH THE LATEST EDITION OF THE MANUAL ON UNIFORM TRAFFIC CONTROL DEVICES (MUTCD). ALL STREET AND REGULATORY SIGNS SHALL BE IN PLACE PRIOR TO THE PLACEMENT OF ANY ASPHALT.
- ALL PLAN DIMENSIONS ARE TO FACE OF CURB AND FACE OF BUILDING UNLESS OTHERWISE NOTED.
- THE EXISTING TOPOGRAPHY IS TAKEN FROM FIELD SURVEY WITH MAXIMUM TWO FOOT CONTOUR INTERVALS PREPARED BY RIEMER MUEGGE & ASSOC. DATED AUGUST, 1997.
- THE COORDINATES SHOWN HEREON ARE BASED UPON THE HOWARD COUNTY GEODETIC CONTROL WHICH IS BASED UPON THE MARYLAND STATE PLANE COORDINATE SYSTEM. STATION NUMBERS 37GC AND 37HC WERE USED.
- WATER IS PUBLIC, CONTRACT NO. 320-W.
- SEWER IS PUBLIC, SEWER DRAINAGE AREA: DORSEY TREATMENT PLANT: DORSEY RUN PUMPING STATION CONTRACT NO. 24-3529-D.
- STORMWATER MANAGEMENT IS PROVIDED VIA A BAYSAYER UNIT AND AN EXPANSION OF THE OFF-SITE RETENTION POND CONSTRUCTED UNDER SDP-97-106. A SHARED MAINTENANCE AGREEMENT FOR USE OF THE PRIVATE SWM FACILITY HAS BEEN RECORDED IN THE LAND RECORDS OFFICE OF HOWARD COUNTY, MD. AS LIBER NO. 4834 / FOLIO NO. 520.
- APPROXIMATE LOCATION OF EXISTING UTILITIES ARE SHOWN. THE CONTRACTOR SHALL TAKE ALL NECESSARY PRECAUTIONS TO PROTECT THE EXISTING UTILITIES AND MAINTAIN UNINTERRUPTED SERVICE. ANY DAMAGE INCURRED DUE TO CONTRACTOR'S OPERATION SHALL BE REPAIRED IMMEDIATELY AT THE CONTRACTOR'S EXPENSE. EXISTING UTILITIES ARE SHOWN BASED ON THE BEST AVAILABLE INFORMATION.
- A 100-YEAR FLOODPLAIN STUDY IS NOT REQUIRED FOR THIS PROJECT.
- A NOISE STUDY IS NOT REQUIRED FOR THIS PROJECT.
- THE GEOTECHNICAL STUDY FOR THIS PROJECT WAS PERFORMED BY LAW ENGINEERING AND ENVIRONMENTAL SERVICES, INC. AND IS DATED JUNE 18, 1996. A SUPPLEMENTAL STORMWATER MANAGEMENT GEOTECHNICAL REPORT WAS PERFORMED BY ENGINEERING CONSULTING SERVICES DATED APRIL, 1997.
- THE BOUNDARY SURVEY FOR THIS PROJECT WAS PERFORMED BY RIEMER MUEGGE & ASSOCIATES, INC. DATED MAY, 1997.
- SUBJECT PROPERTY ZONED B-1 & B-2 PER 10-18-93 COMPREHENSIVE ZONING PLAN.
- ALL ELEVATIONS SHOWN ARE BASED ON THE U.S.C. AND G.S. MEAN SEA LEVEL DATUM, 1929.
- SEE DEPARTMENT OF PLANNING AND ZONING FILE NO'S - SDP-97-106, F-98-56(FOOD LION SITE)
- THE CONTRACTOR SHALL TEST PIT EXISTING UTILITIES AT LEAST (5) DAYS BEFORE STARTING WORK SHOWN ON THESE DRAWINGS.
- CONTRACTOR IS SOLELY RESPONSIBLE FOR CONSTRUCTION MEANS, METHODS, TECHNIQUES, SEQUENCES, PROCEDURES, AND SAFETY PRECAUTIONS AND PROGRAMS.
- PIPE SHALL NOT BE INSTALLED BY THE CONTRACTOR UNTIL THE LENGTH CALLED FOR AT EACH STATION HAS BEEN APPROVED BY THE ENGINEER IN THE FIELD.
- NO PIPE SHALL BE LAID UNTIL LINES OF EXCAVATION HAVE BEEN BROUGHT WITHIN 6" OF FINISHED GRADE.
- ALL STORM DRAIN PIPE BEDDING SHALL BE CLASS 'C' AS SHOWN IN FIG. 11.4, VOLUME 1 OF HOWARD COUNTY DESIGN MANUAL UNLESS OTHERWISE NOTED.
- ALL INLETS SHALL BE CONSTRUCTED IN ACCORDANCE WITH HOWARD COUNTY STANDARDS.
- ALL PIPE ELEVATIONS SHOWN ARE INVERT ELEVATIONS.
- STORM DRAIN TRENCHES WITHIN ROAD RIGHT OF WAY SHALL BE BACKFILLED AND COMPACTED IN ACCORDANCE WITH THE HOWARD COUNTY DESIGN MANUAL, VOLUME IV, i.e., STANDARD SPECIFICATIONS AND DETAILS FOR CONSTRUCTION, LATEST AMENDMENTS.
- PROFILES STATIONS SHALL BE ADJUSTED AS NECESSARY TO CONFORM TO PLAN DIMENSIONS.
- ALL FILL AREAS WITHIN ROADWAY AND UNDER STRUCTURES TO BE COMPACTED TO A MINIMUM OF 95% COMPACTION OF AASHTO T180.
- THERE ARE NO WETLANDS ON-SITE FOR THIS PROJECT BASED ON A FIELD INSPECTION CONDUCTED BY RNA, INC. ON MARCH, 1999.
- A LANDSCAPE PLAN HAS BEEN PREPARED IN ACCORDANCE TO SECTION 16.124 OF THE HOWARD COUNTY CODE AND LANDSCAPE MANUAL FOR THIS SITE. SEE SHEET 8 FOR THE REQUIRED FINANCIAL SURETY.
- A CROSS-EASEMENT TO UTILIZE THE USE-IN-COMMON ACCESS EASEMENT ACROSS PARCELS A AND B OF THE FOOD LION SITE AND PARCEL 262 HAS BEEN RECORDED IN THE LAND RECORDS OFFICE OF HOWARD COUNTY, MARYLAND, AS LIBER 1634 FOLIO 561.
- THE FOREST CONSERVATION OBLIGATIONS INCURRED BY THIS PROJECT (0.23 ACRES OF AFFORESTATION) HAS BEEN MET BY PAYMENT OF A FEE-IN-LIEU IN THE AMOUNT OF \$3005.64.
- DESIGN MANUAL WAIVER REQUEST DATED 3-24-99 WAIVING SECTIONS 5.2.6.A, 5.2.6.D-1, 5.2.6.E AND 5.2.6.F WERE APPROVED BY DEVELOPMENT ENGINEERING DIVISION ON 4-2-99 AND 6-24-99.


# CVS

## SITE DEVELOPMENT PLAN

### RETAIL STORE

#### 6th ELECTION DISTRICT


#### HOWARD COUNTY, MARYLAND

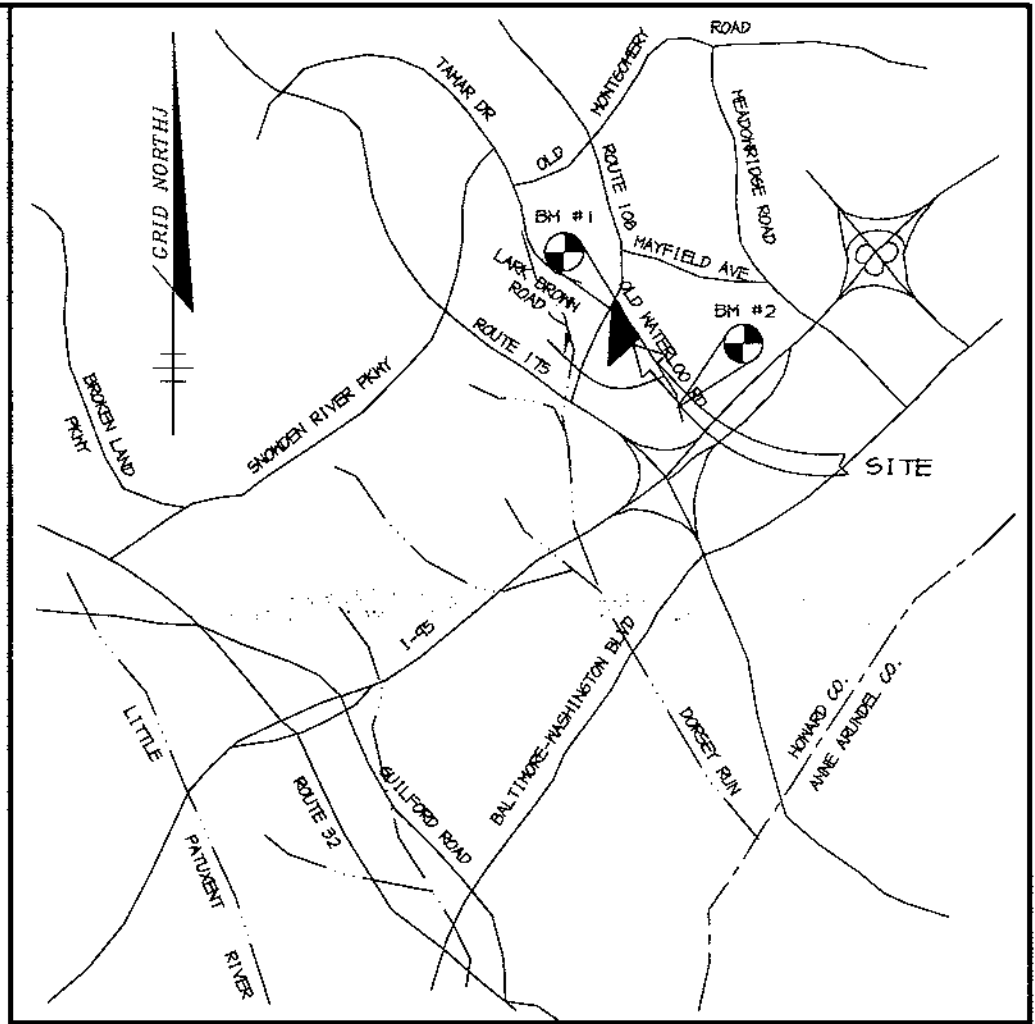

VICINITY MAP  
SCALE: 1" = 2000'

SITE ANALYSIS

AREA OF PARCEL 259	0.328 ACRES (14,267 SF)
AREA OF PARCEL 260	1.215 ACRES (52,924 SF)
TOTAL:	1.543 ACRES (67191 SF)
DISTURBED AREA	2.30 ACRES (100,188.00 SF)
PRESENT ZONING	B-1 & B-2
PROPOSED USE	RETAIL
BUILDING COVERAGE	10,094 SF (15.02% OF SITE)
# OF PARKING SPACES REQUIRED @ 5.0 SP/1000 SF	51 SPACES
# OF PARKING SPACES PROVIDED	52 SPACES (3 HC)
PAVED AREA	52,272 SF (77.80% OF SITE)

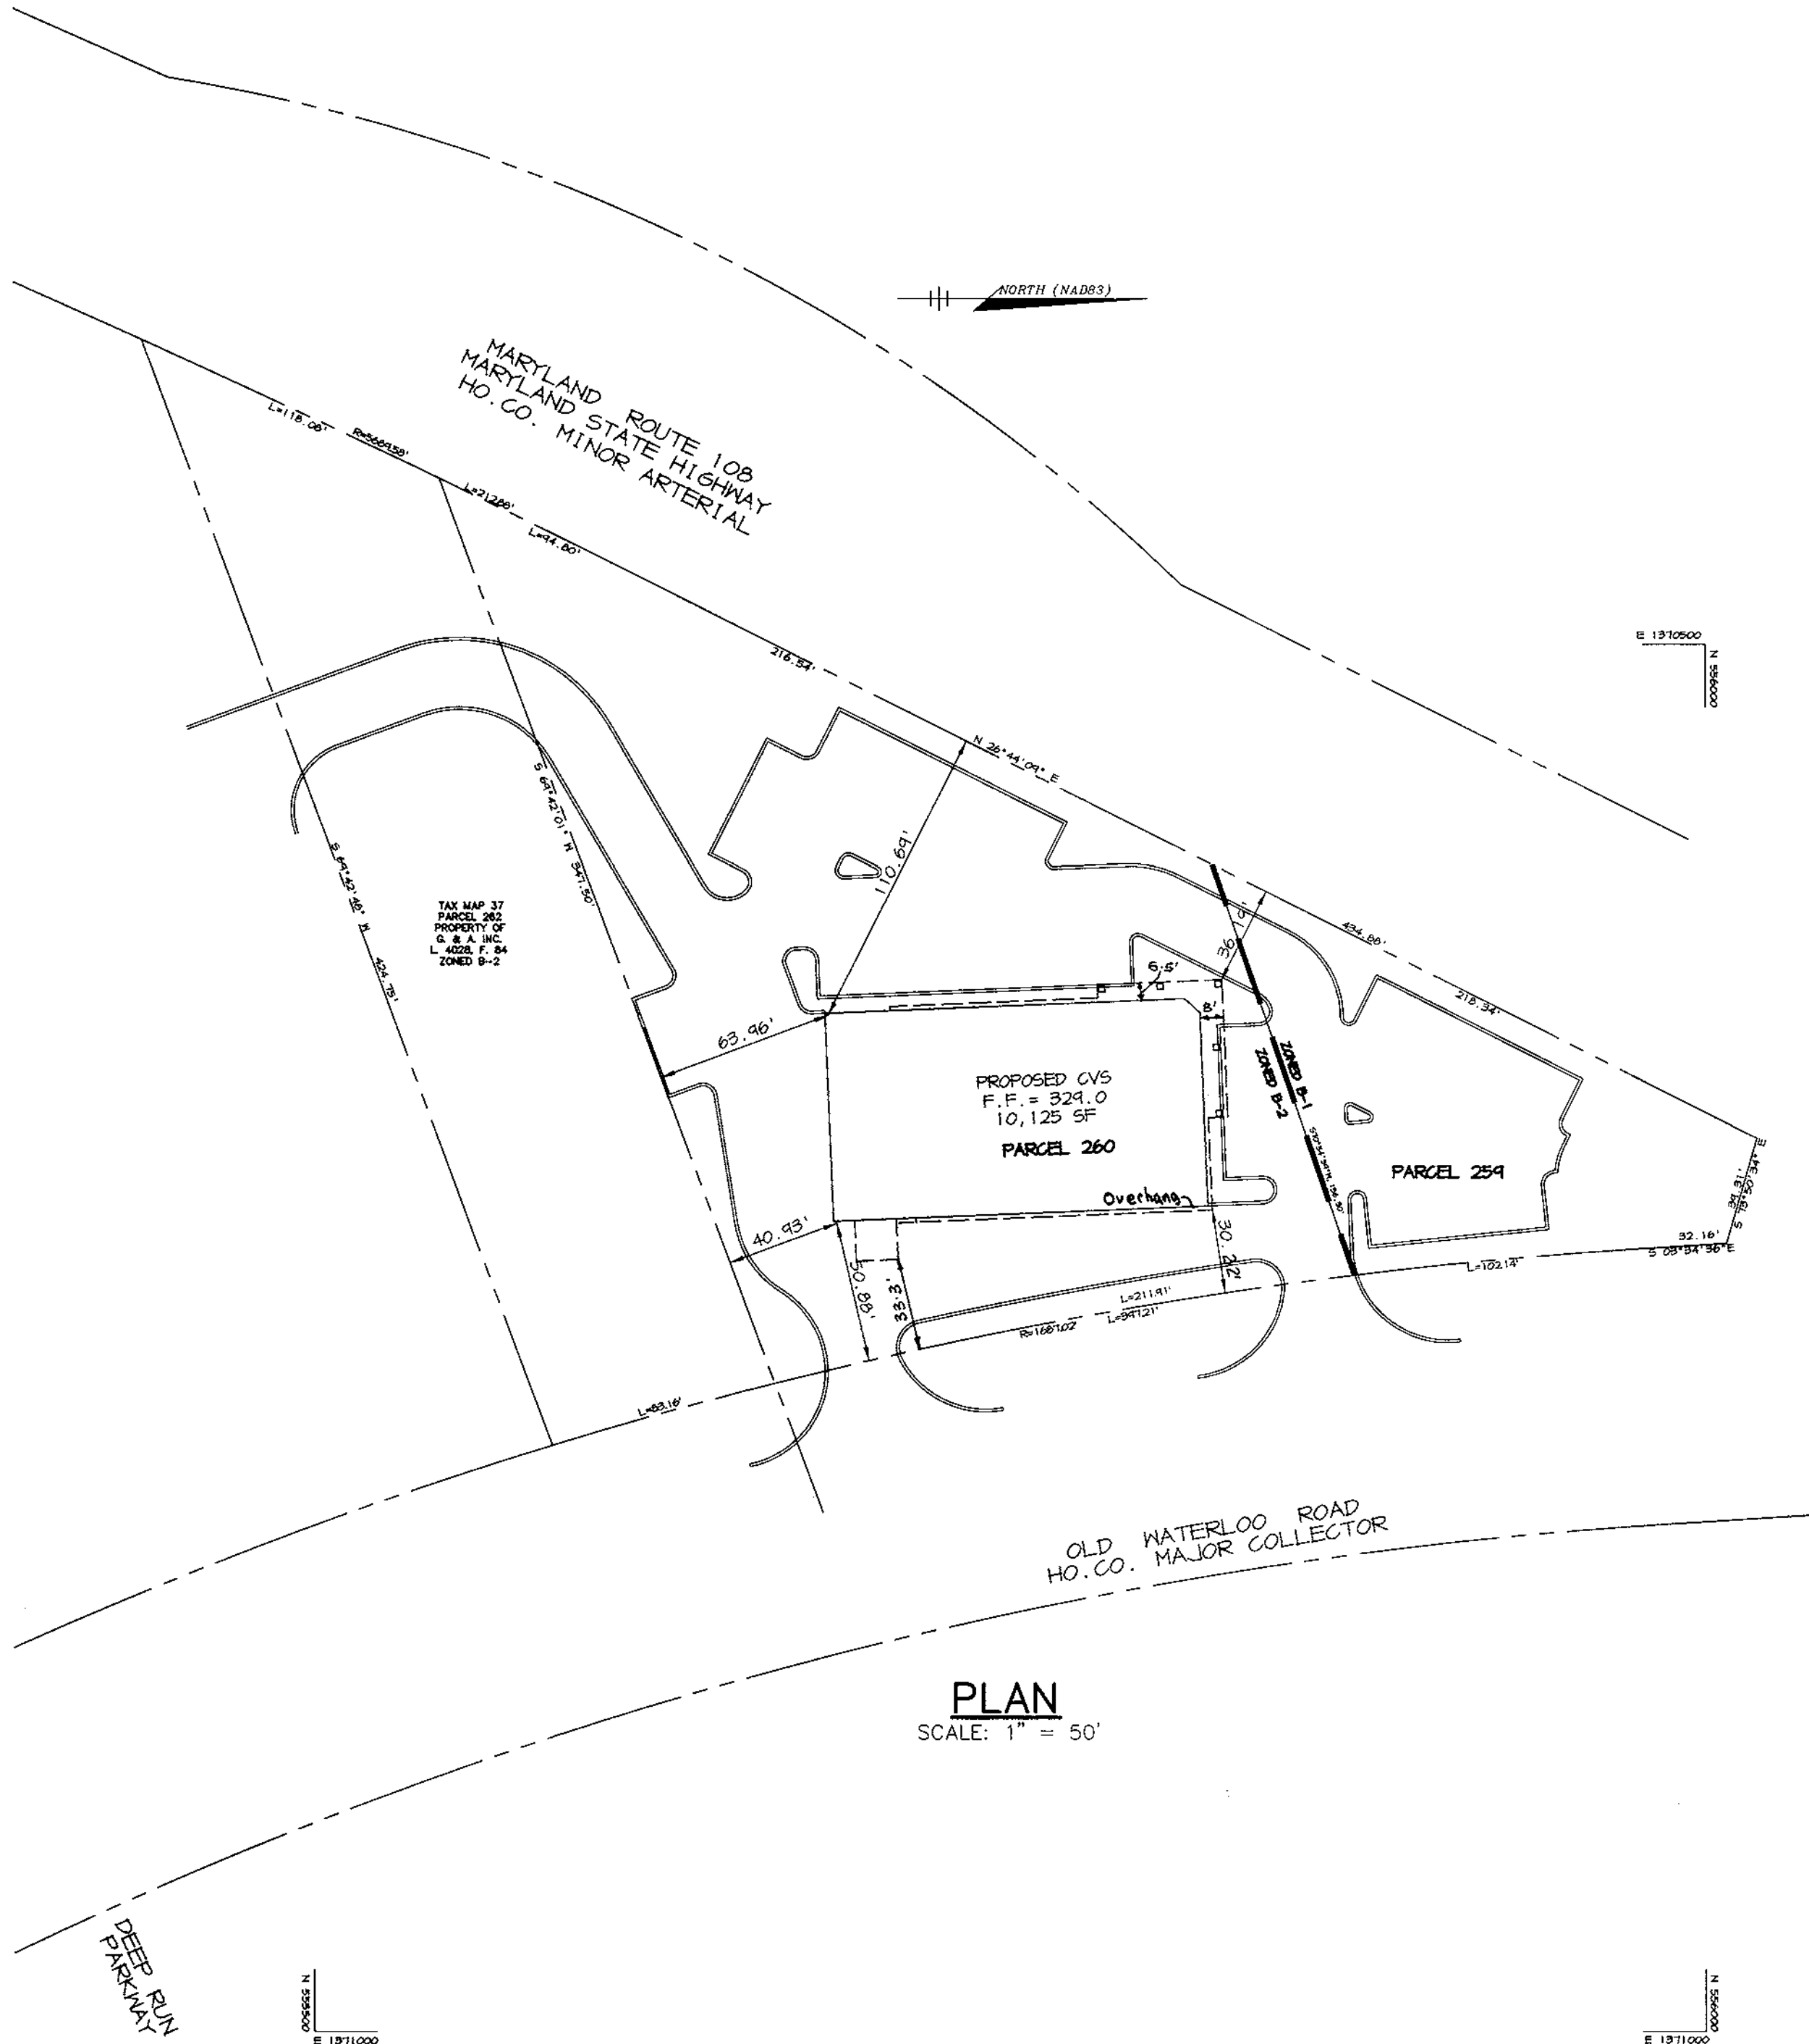

PLAN  
SCALE: 1" = 50'

AS-BUILT CONTROL BENCHMARKS

✓BM #1  
HOCO MONUMENT 37GC  
ELEV. 331.93  
N 555,250.79 E 1,370,946.36

✓BM #2  
HOCO MONUMENT 37HC  
ELEV. 291.79  
N 552,854.21 E 1,372,639.50

AS-BUILT CERTIFICATE

Christopher J. Reid 9-12-00  
CHRISTOPHER J. REID #19949 DATE

ADDRESS CHART

PARCEL	STREET ADDRESS
259 & 260	6480 OLD WATERLOO ROAD

SUBDIVISION NAME	CVS PHARMACY	SECT./AREA	254 & 260
PLAT #	N/A	BLOCK #	14 & 20
		ZONING	B-1 B-2
		TAX MAP NO.	37
		ELECT. DIST.	6th
		CENSUS TRACT	6067.03
WATER CODE	EOB	SEWER CODE	3460000

APPROVED : FOR PUBLIC WATER AND PUBLIC SEWERAGE SYSTEMS, HOWARD COUNTY HEALTH DEPARTMENT.

Dione Matuszak M.D. 11/9/99  
COUNTY HEALTH OFFICER DATE

APPROVED : HOWARD COUNTY DEPARTMENT OF PLANNING AND ZONING.

James S. Smith 11/15/99  
DIRECTOR DATE

Chief, Development Engineering Division 11/4/99  
DATE

Cindy Hammit 11/13/99  
CHIEF, DIVISION OF LAND DEVELOPMENT DATE

DATE	NO.	REVISION

OWNER	OWNER
AUDREY OWENS ETAL 7533 GLENEAGLE DR. JESSUP, MD 20794 (410) 799-4655	OM HOSPITALITY MANAGEMENT, INC. 6251 WASHINGTON BLVD. ELK RIDGE, MD 21075 (410) 379-3095

DEVELOPER

ASTON PROPERTIES  
6525 MORRISON BLVD., SUITE 300  
CHARLOTTE, NC 28211  
(704) 366-1331

PROJECT

CVS  
RETAIL STORE

AREA

Parcels 259 & 260  
Tax Map 37 Block 14, 20 Zoned B-1, B-2  
6th Election District  
Howard County, Maryland

TITLE

TITLE SHEET

RIEMER MUEGGE & ASSOCIATES INC.

ENGINEERING • ENVIRONMENTAL SERVICES • PLANNING • SURVEYING

8818 Centre Park Drive, Columbia, MD 21045  
tel 410.997.8900 fax 410.997.9282


DATE	DESIGNED BY : C.J.R.
DATE	DRAWN BY : D.A.M.
PROJECT NO : SDP-99-123	
DATE : OCTOBER 13, 1999	
SCALE : AS SHOWN	
DRAWING NO. : 1 OF 8	

NOTE: SEE ARCHITECTURAL DRAWINGS FOR COMPLETE BUILDING DETAILS AND ELEVATIONS.

WEST ELEVATION - BUILDING A

NO SCALE




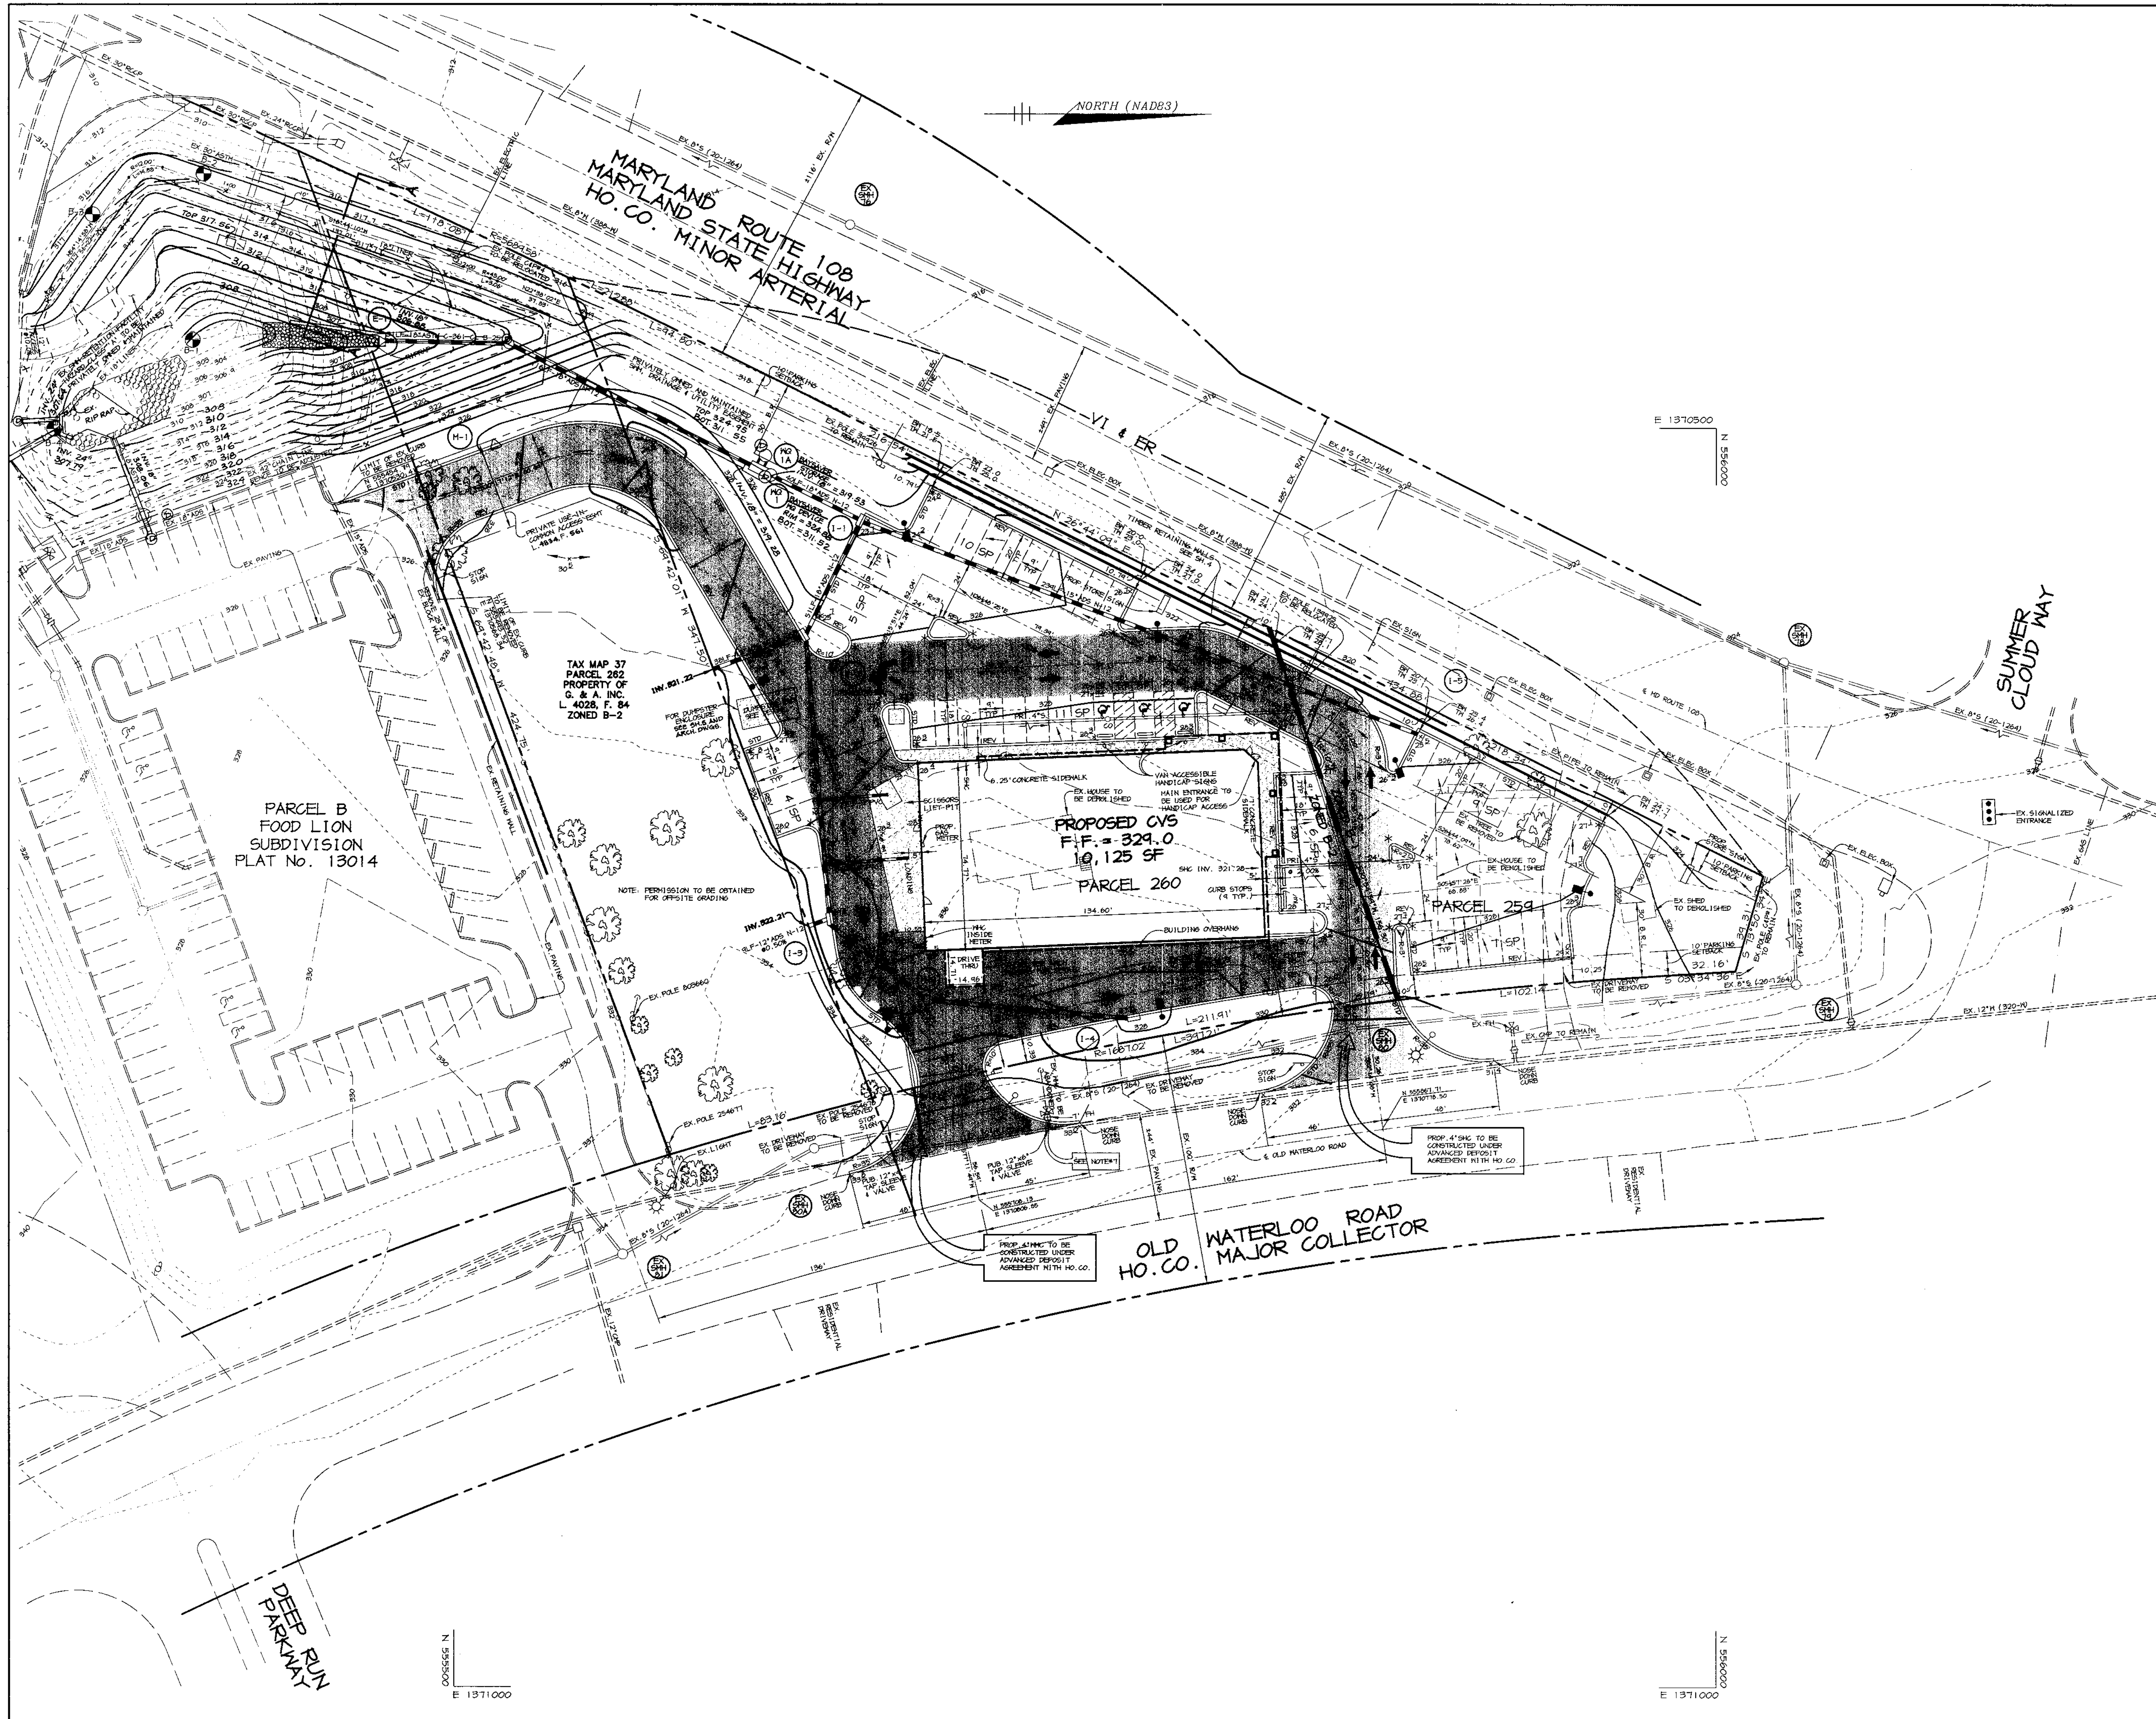

- LEGEND**
- P-1 PAVING
  - P-3 PAVING (HEAVY DUTY PAVING)
  - STREET LIGHT-SEE NOTE
  - SITE LIGHT (SINGLE)-SEE NOTE
- NOTES:**
- STREET LIGHTS TO BE 150 WATT VAPOR PENDANT FIXTURES MOUNTED AT 30' WITH BRONZE FIBERGLASS POLE AND 12" ARM. SITE LIGHTS TO BE 1000 WATT METAL HALIDE VERTICAL LAMPS ON SHOCKBOXES ON 2'-6" BASE WITH 3/4" POLE (SINGLE, DOUBLE, OR QUAD) - SEE LIGHT POLE DETAIL SHEET 4
  - ALL OUTDOOR LIGHTING TO BE IN ACCORDANCE WITH SEC. 184 OF THE ZONING REGULATIONS. SEE SHEET 4 FOR DETAIL.
  - ALL CURB RADIUS ARE 5' UNLESS OTHERWISE LABELED.
  - ALL DIMENSIONS ARE TO FACE OF CURB OR BUILDING UNLESS OTHERWISE LABELED.
  - \* LIMITS OF STD/REV CURB AND GUTTER.
  - SEE TITLE SHEET FOR BUILDING LOCATION DIMENSIONS.
  - HW ABANDONMENT PROCEDURES:  
A. CONTACT BUREAU OF UTILITIES.  
B. SEWER AT CORPORATION GAGE AND ENCASE IN CONCRETE AT MAIN. PROPOSED FIRE HYDRANT TO BE CONSTRUCTED UNDER ADD.
  - SHC ABANDONMENT PROCEDURES:  
A. CONTACT BUREAU OF UTILITIES.  
B. DISCONNECT SHC AND FLUG AT MAIN.
  - VI & ER = VEHICULAR INGRESS AND EGRESS RESTRICTED

AD-BUILT CERTIFICATE	
CHRISTOPHER J. REID # 19949	9.12.00
DATE	
APPROVED : FOR PUBLIC WATER AND PUBLIC SEWERAGE SYSTEMS, HOWARD COUNTY HEALTH DEPARTMENT.	
Diane Matuszak M.D./Jfr	11/9/99
COUNTY HEALTH OFFICER	DATE
APPROVED : HOWARD COUNTY DEPARTMENT OF PLANNING AND ZONING.	
David Smith	11/15/99
DIRECTOR	DATE
Chief, Development Engineering Division	11/4/99
Chief, Division of Land Development	11/12/99
DATE	NO.
REVISION	
OWNER	OWNER
AUDREY OWENS ETAL 7533 GLENEAGLE DR. JESSUP, MD 20794 (410) 749-4655	OM HOSPITALITY MANAGEMENT, INC. 6251 WASHINGTON BLVD. ELKRIDGE, MD 21075 (410) 374-3045
DEVELOPER	
ASTON PROPERTIES 6525 MORRISON BLVD., SUITE 300 CHARLOTTE, NC 28211 (704) 366-7337	
PROJECT	
CVS RETAIL STORE	
AREA	
Parcels 259 & 260 Tax Map 37 Block 14, 20 Zoned B-1, B-2 6th Election District Howard County, Maryland	
TITLE	
SITE DEVELOPMENT PLAN	
RIEMER MUEGGE & ASSOCIATES, INC. ENGINEERING • ENVIRONMENTAL SERVICES • PLANNING • SURVEYING 8818 Centre Park Drive, Columbia, MD 21045 tel 410.987.8800 fax 410.987.8282	
DATE	
DESIGNED BY : C.J.R.	
DRAWN BY : D.A.M.	
PROJECT NO : 98313 SDP2.DWG	
DATE : OCTOBER 13, 1999	
SCALE : 1" = 30'	
DRAWING NO. 2 OF 8	



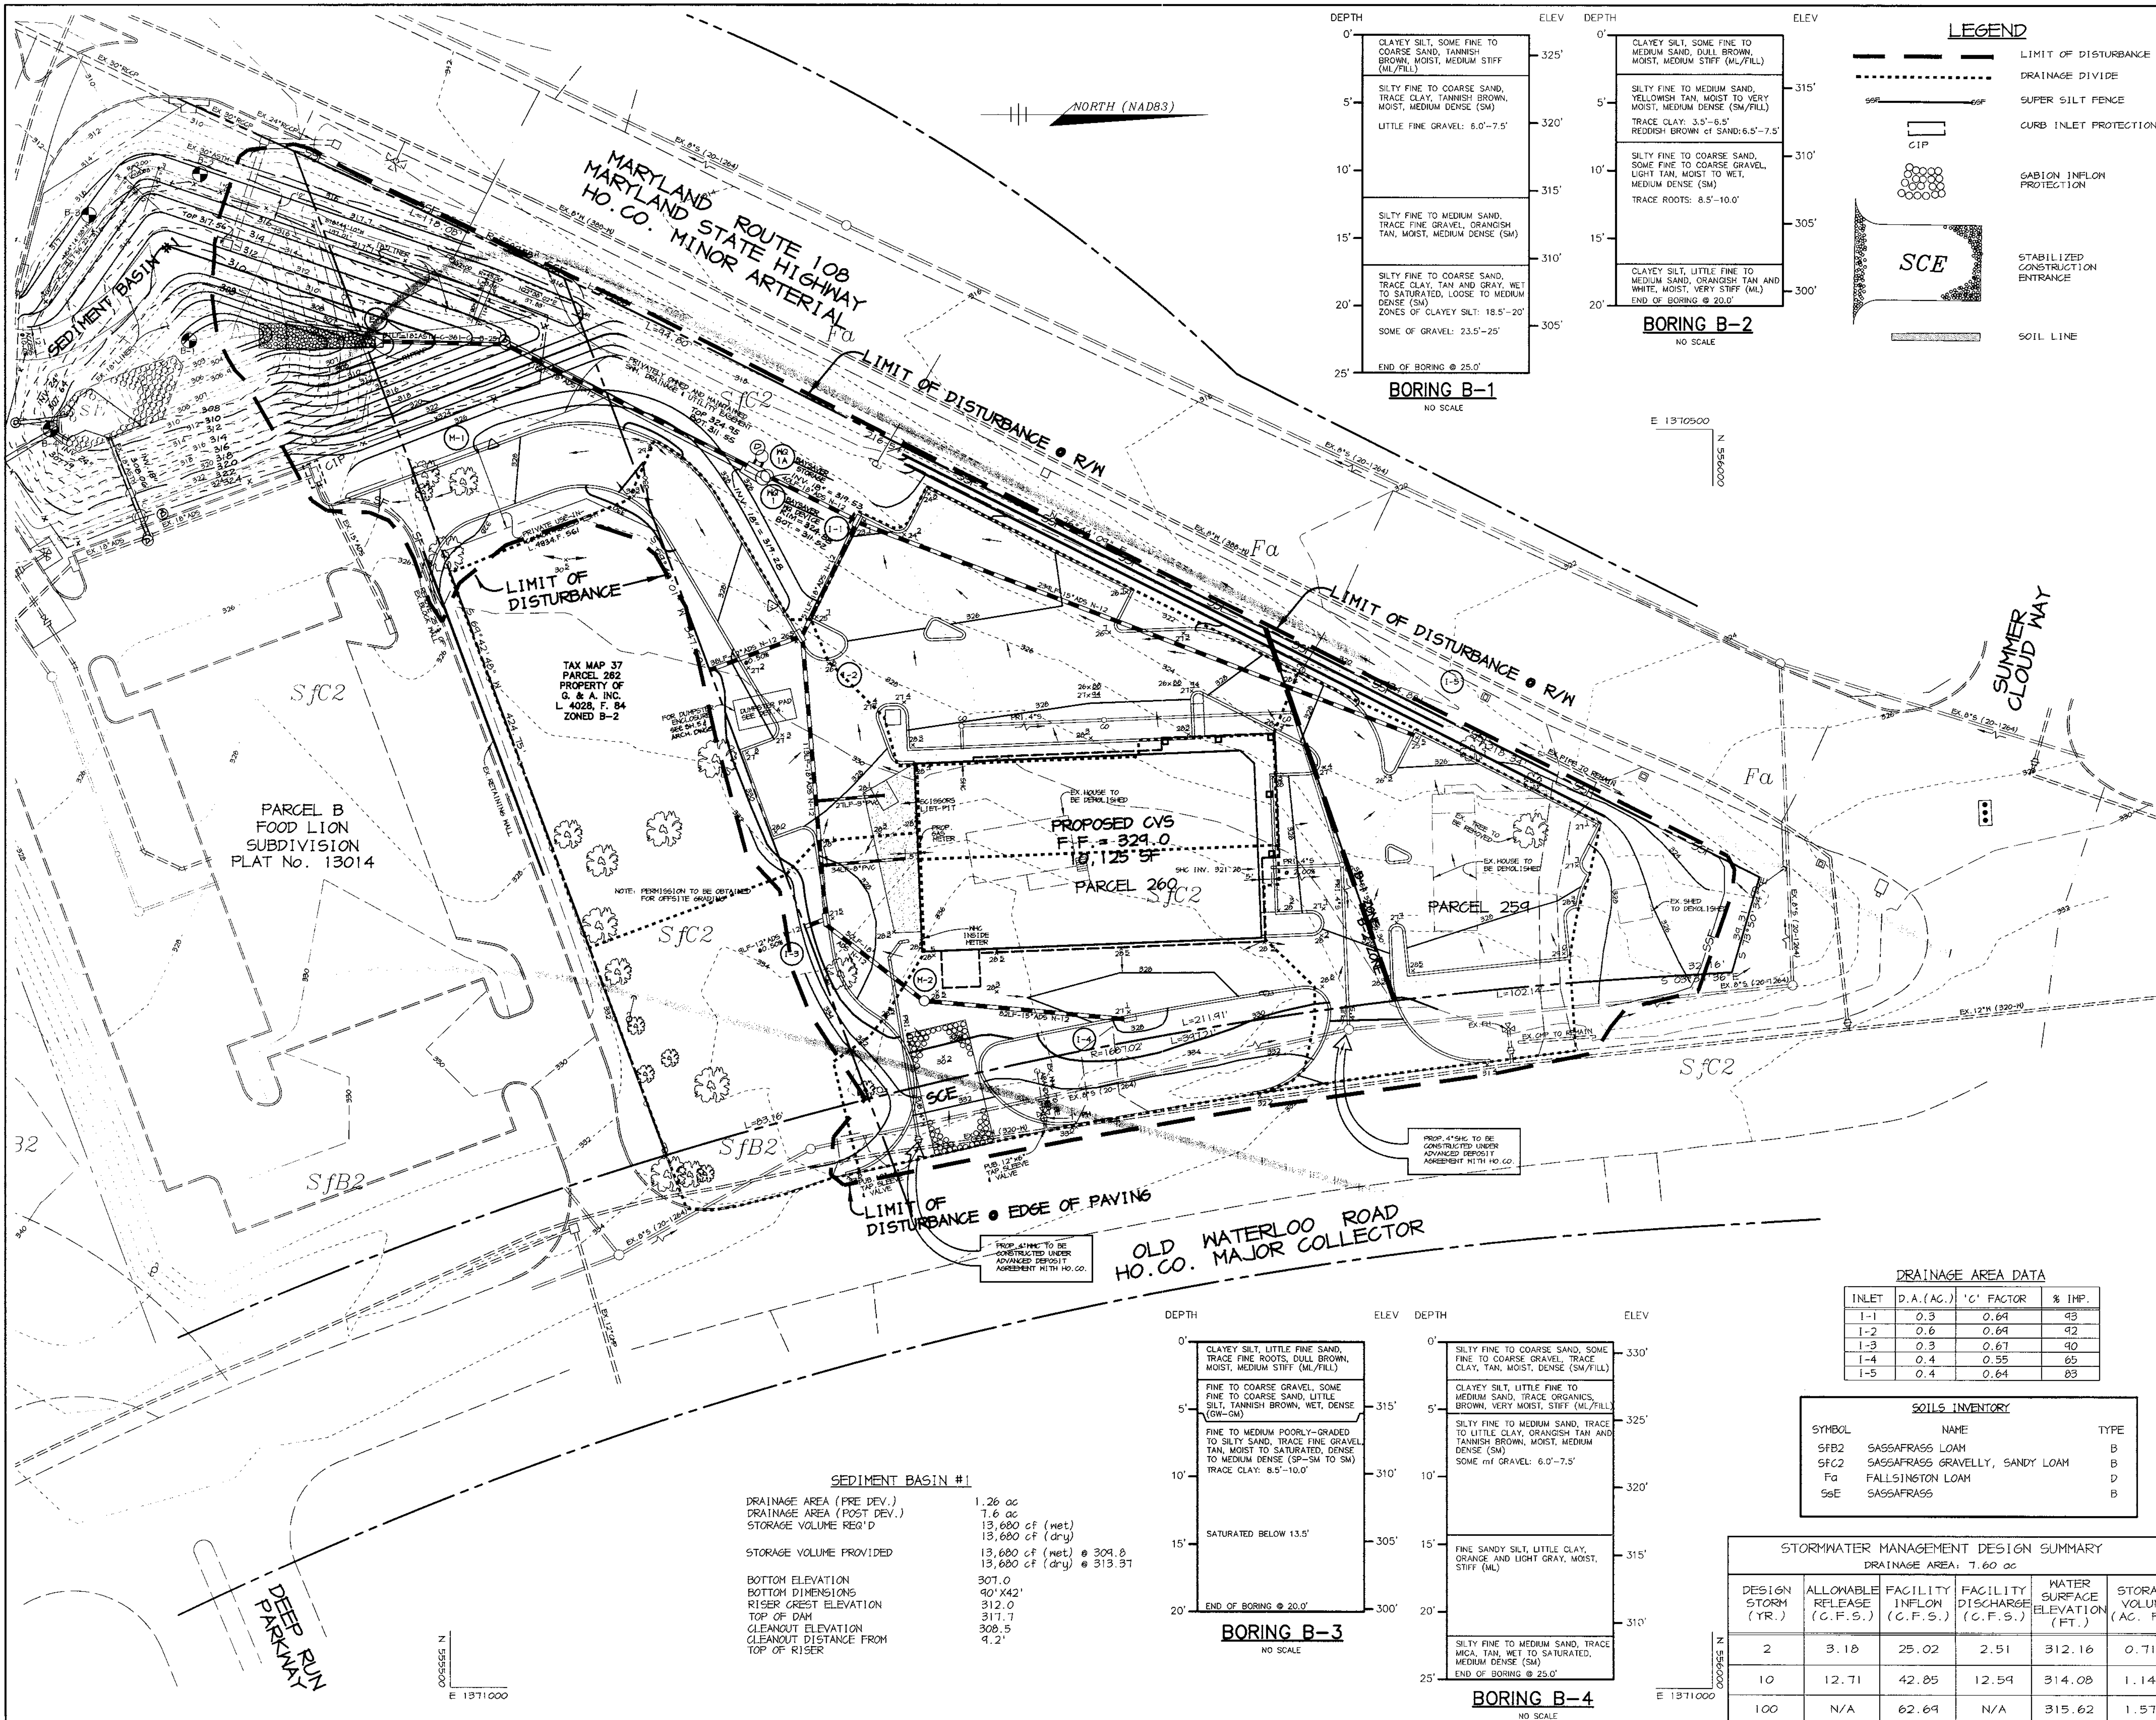

LEGEND

- LIMIT OF DISTURBANCE
- - - DRAINAGE DIVIDE
- SUPER SILT FENCE
- CURB INLET PROTECTION
- GIP
- GABION INFLOW PROTECTION
- SCE
- STABILIZED CONSTRUCTION ENTRANCE
- SOIL LINE

DEPTH ELEV

0'	CLAYEY SILT, SOME FINE TO COARSE SAND, TANNISH BROWN, MOIST, MEDIUM STIFF (ML/FILL)	325'
5'	SILTY FINE TO COARSE SAND, TRACE CLAY, TANNISH BROWN, MOIST, MEDIUM DENSE (SM)	320'
10'	LITTLE FINE GRAVEL: 6.0'-7.5'	315'
15'	SILTY FINE TO MEDIUM SAND, TRACE FINE GRAVEL, ORANGISH TAN, MOIST, MEDIUM DENSE (SM)	310'
20'	SILTY FINE TO COARSE SAND, TRACE FINE GRAVEL, ORANGISH TAN, MOIST, MEDIUM DENSE (SM)	305'
25'	END OF BORING @ 25.0'	

BORING B-1  
NO SCALE

DEPTH ELEV

0'	CLAYEY SILT, SOME FINE TO MEDIUM SAND, DULL BROWN, MOIST, MEDIUM STIFF (ML/FILL)	315'
5'	SILTY FINE TO MEDIUM SAND, YELLOWISH TAN, MOIST TO VERY MOIST, MEDIUM DENSE (SM/FILL)	310'
10'	TRACE CLAY: 3.5'-6.5'	305'
15'	SILTY FINE TO COARSE SAND, SOME FINE TO COARSE GRAVEL, LIGHT TAN, MOIST TO WET, MEDIUM DENSE (SM)	300'
20'	TRACE ROOTS: 8.5'-10.0'	
25'	CLAYEY SILT, LITTLE FINE TO MEDIUM SAND, ORANGISH TAN AND WHITE, MOIST, VERY STIFF (ML)	
30'	END OF BORING @ 30.0'	

BORING B-2  
NO SCALE

DEPTH ELEV

0'	CLAYEY SILT, LITTLE FINE SAND, TRACE FINE ROOTS, DULL BROWN, MOIST, MEDIUM STIFF (ML/FILL)	315'
5'	FINE TO COARSE GRAVEL, SOME FINE TO COARSE SAND, LITTLE SILT, TANNISH BROWN, WET, DENSE (GW-GM)	310'
10'	FINE TO MEDIUM POORLY-GRADED TO SILTY SAND, TRACE FINE GRAVEL, TAN, MOIST TO SATURATED, DENSE TO MEDIUM DENSE (SP-SM TO SM)	305'
15'	TRACE CLAY: 8.5'-10.0'	300'
20'	SATURATED BELOW 13.5'	
25'	END OF BORING @ 20.0'	

BORING B-3  
NO SCALE

DEPTH ELEV

0'	SILTY FINE TO COARSE SAND, SOME FINE TO COARSE GRAVEL, TRACE CLAY, TAN, MOIST, DENSE (SM/FILL)	330'
5'	CLAYEY SILT, LITTLE FINE TO MEDIUM SAND, TRACE ORANGISH BROWN, VERY MOIST, STIFF (ML/FILL)	325'
10'	SILTY FINE TO MEDIUM SAND, TRACE TO LITTLE CLAY, ORANGISH TAN AND MEDIUM SAND, TRACE ORANGISH BROWN, MOIST, MEDIUM DENSE (SM)	320'
15'	SOME MF GRAVEL: 6.0'-7.5'	315'
20'	FINE SANDY SILT, LITTLE CLAY, ORANGE AND LIGHT GRAY, MOIST, STIFF (ML)	310'
25'	SILTY FINE TO MEDIUM SAND, TRACE MICA, TAN, WET TO SATURATED, MEDIUM DENSE (SM)	305'
30'	END OF BORING @ 25.0'	

BORING B-4  
NO SCALE

DRAINAGE AREA DATA

INLET	D.A.(AC.)	'C' FACTOR	% IMP.
1-1	0.3	0.69	43
1-2	0.6	0.69	42
1-3	0.3	0.67	40
1-4	0.4	0.55	65
1-5	0.4	0.64	83

SOILS INVENTORY

SYMBOL	NAME	TYPE
SFB2	SASSAFRASS LOAM	B
SFC2	SASSAFRASS GRAVELLY, SANDY LOAM	B
Fa	FALLSINGTON LOAM	D
SsE	SASSAFRASS	B

STORMWATER MANAGEMENT DESIGN SUMMARY

DESIGN STORM (YR.)	ALLOWABLE RELEASE (C.F.S.)	FACILITY INFLOW (C.F.S.)	FACILITY DISCHARGE (C.F.S.)	WATER SURFACE ELEVATION (FT.)	STORAGE VOLUME (AC. FT.)
2	3.18	25.02	2.51	312.16	0.712
10	12.71	42.85	12.59	314.08	1.144
100	N/A	62.69	N/A	315.62	1.578

SEDIMENT BASIN #1

DRAINAGE AREA (PRE DEV.)	1.26 ac
DRAINAGE AREA (POST DEV.)	7.6 ac
STORAGE VOLUME REQ'D	13,680 cf (wet)
	13,680 cf (dry)
STORAGE VOLUME PROVIDED	13,680 cf (wet) @ 309.8
	13,680 cf (dry) @ 313.37
BOTTOM ELEVATION	307.0
BOTTOM DIMENSIONS	40'x42'
RISER GREST ELEVATION	312.0
TOP OF DAM	317.7
CLEANOUT ELEVATION	308.5
CLEANOUT DISTANCE FROM TOP OF RISER	4.2'

**CERTIFICATE**

*Christopher J. Reid*  
CHRISTOPHER J. REID #19949  
DATE 9-12-00

BY THE DEVELOPER:

I/WE CERTIFY THAT ALL DEVELOPMENT AND/OR CONSTRUCTION WILL BE DONE ACCORDING TO THESE PLANS, AND THAT ANY RESPONSIBLE PERSONNEL INVOLVED IN THE CONSTRUCTION PROJECT WILL HAVE A CERTIFICATE OF ATTENDANCE AT A DEPARTMENT OF THE ENVIRONMENT APPROVED TRAINING PROGRAM FOR THE CONTROL OF SEDIMENT AND EROSION BEFORE BEGINNING THE PROJECT. I SHALL ENGAGE A REGISTERED PROFESSIONAL ENGINEER TO SUPERVISE POND CONSTRUCTION AND PROVIDE THE HOWARD SOIL CONSERVATION DISTRICT WITH AN "AS-BUILT" PLAN OF THE POND WITHIN 30 DAYS OF COMPLETION. I ALSO AUTHORIZE PERIODIC ON-SITE INSPECTIONS BY THE HOWARD SOIL CONSERVATION DISTRICT.

*Arthur E. Muegge*  
DEVELOPER  
DATE 10-7-99

BY THE ENGINEER:

I CERTIFY THAT THIS PLAN FOR POND CONSTRUCTION, EROSION AND SEDIMENT CONTROL REPRESENTS A PRACTICAL AND WORKABLE PLAN BASED ON MY PERSONAL KNOWLEDGE OF THE SITE CONDITIONS. THIS PLAN WAS PREPARED IN ACCORDANCE WITH THE REQUIREMENTS OF THE HOWARD SOIL CONSERVATION DISTRICT. I HAVE NOTIFIED THE DEVELOPER THAT HE/SHE MUST ENGAGE A REGISTERED PROFESSIONAL ENGINEER TO SUPERVISE POND CONSTRUCTION AND PROVIDE THE HOWARD SOIL CONSERVATION DISTRICT WITH AN "AS-BUILT" PLAN OF THE POND WITHIN 30 DAYS OF COMPLETION.

*Arthur E. Muegge*  
ENGINEER  
DATE 8-6-99

THESE PLANS HAVE BEEN REVIEWED FOR THE HOWARD SOIL CONSERVATION DISTRICT AND MEET THE TECHNICAL REQUIREMENTS FOR SMALL POND CONSTRUCTION, SOIL EROSION AND SEDIMENT CONTROL.

*Chris Simon*  
NATURAL RESOURCES CONSERVATION SERVICE  
DATE 11/2/99

THESE PLANS FOR SMALL POND CONSTRUCTION, SOIL EROSION AND SEDIMENT CONTROL MEET THE REQUIREMENTS OF THE HOWARD SOIL CONSERVATION DISTRICT.

*John Smith*  
HOWARD SOIL CONSERVATION DISTRICT  
DATE 11/2/99

APPROVED: FOR PUBLIC WATER AND PUBLIC SEWERAGE SYSTEMS, HOWARD COUNTY HEALTH DEPARTMENT.

*Diane Matuszok*  
COUNTY HEALTH OFFICER  
DATE 11/9/99

APPROVED: HOWARD COUNTY DEPARTMENT OF PLANNING AND ZONING.

*John Smith*  
DIRECTOR  
DATE 11/15/99

*John Smith*  
CHIEF, DEVELOPMENT ENGINEERING DIVISION  
DATE 11/9/99

*Chris Hamilton*  
CHIEF, DIVISION OF LAND DEVELOPMENT  
DATE 11/9/99

DATE	NO.	REVISION

OWNER	OWNER
AUDREY OWENS ETAL 7533 GLENLEAGUE DR. JESSUP, MD 20794 (410) 799-4655	OM HOSPITALITY MANAGEMENT, INC. 6251 WASHINGTON BLVD. ELKRIDGE, MD 21075 (410) 319-3045

DEVELOPER

ASTON PROPERTIES  
6525 MORRISON BLVD., SUITE 300  
CHARLOTTE, NC 28211  
(704) 366-7337

PROJECT

CVS  
RETAIL STORE

AREA

Parcels 259 & 260  
Tax Map 37 Block 14, 20 Zoned B-1, B-2  
6th Election District  
Howard County, Maryland

TITLE

DRAINAGE AREA MAP  
GRADING AND  
SEDIMENT CONTROL PLAN

RIEMER MUEGGE & ASSOCIATES INC.

ENGINEERING • ENVIRONMENTAL SERVICES • PLANNING • SURVEYING

8818 Centre Park Drive, Columbia, MD 21045  
Tel 410.997.9800 Fax 410.997.9282

DATE

DESIGNED BY: C.J.R.

DRAWN BY: D.A.M.

PROJECT NO.: 98313  
SDP3.DWG

DATE: OCTOBER 13, 1999


SCALE: 1" = 30'

DRAWING NO.: 3 OF 8


ARTHUR E. MUEGGE #8707

AS-BUILT 9/11/00 SDP-99-123




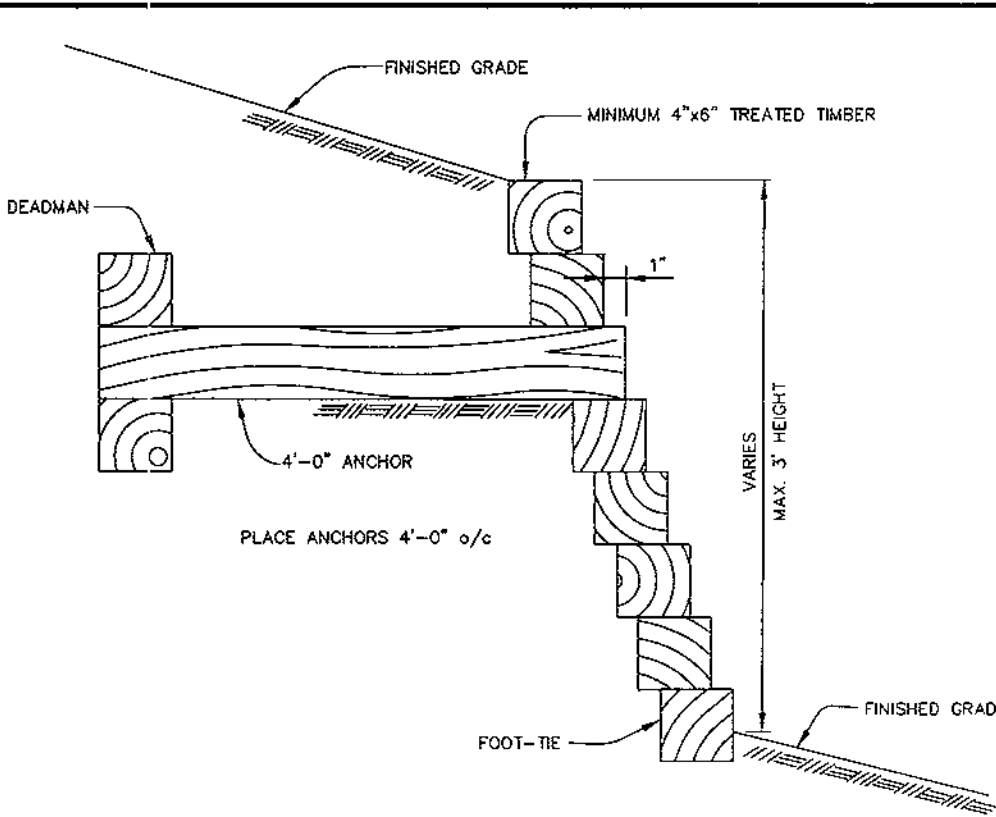


TIMBER RETAINING WALL DETAIL

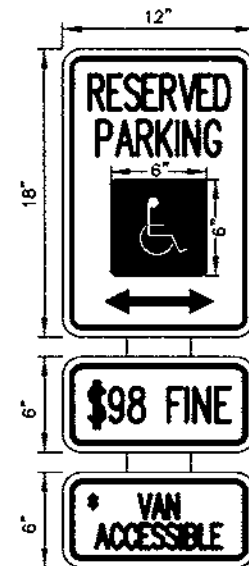


**HANDICAP SIGN DETAIL**

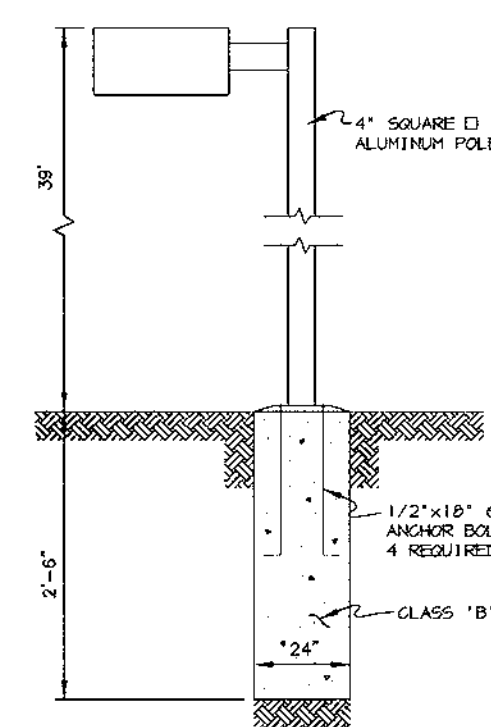


LIGHT POLE DETAIL

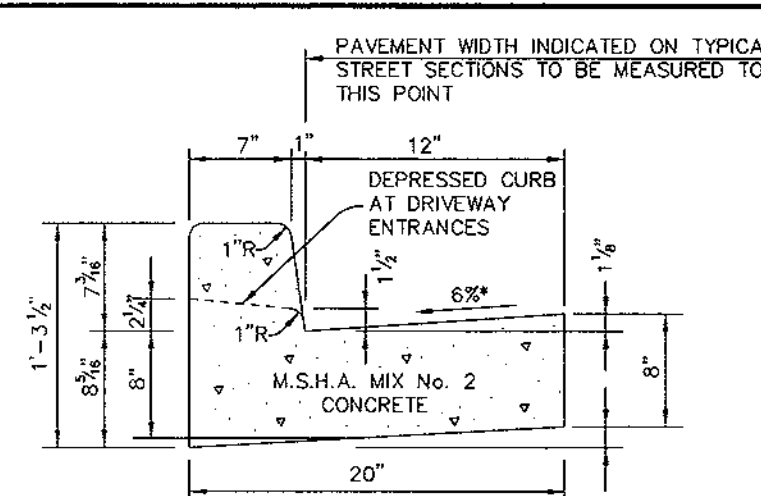


STANDARD 7" COMBINATION  
CURB AND GUTTER

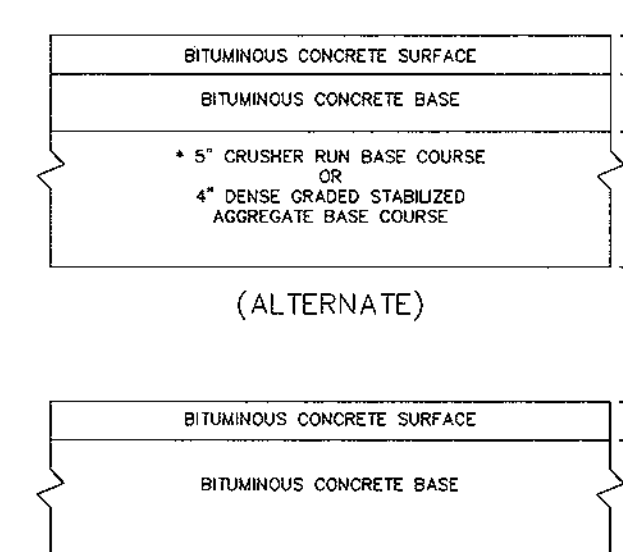


## P-1 PAVING

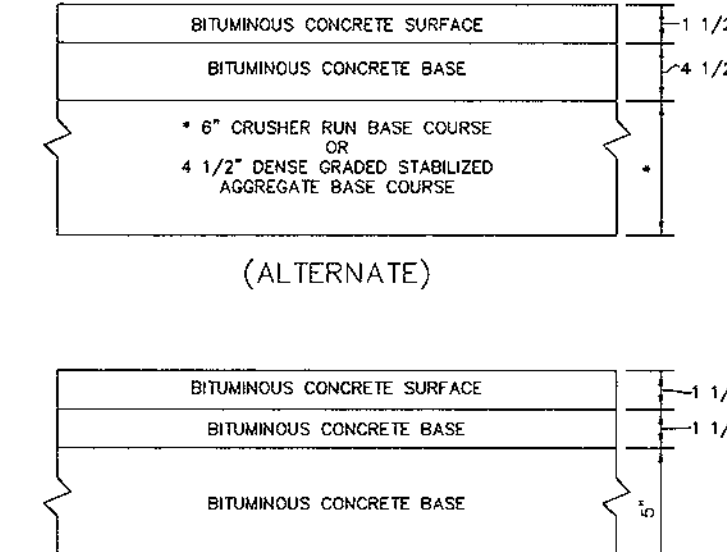


### P-3 PAVING

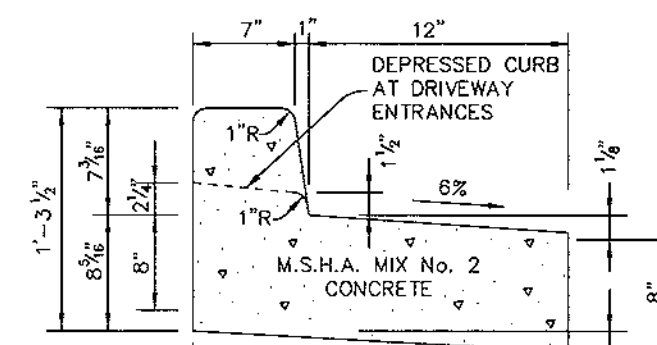


REVERSE 7" COMBINATION  
CURB AND GUTTER

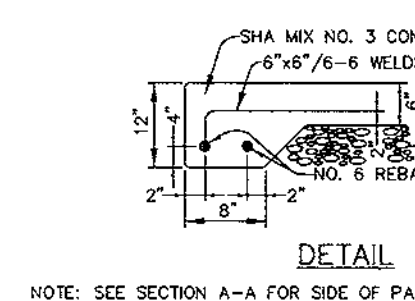


SECTION  
LOADING AREA  
CONCRETE PAD DETAILS

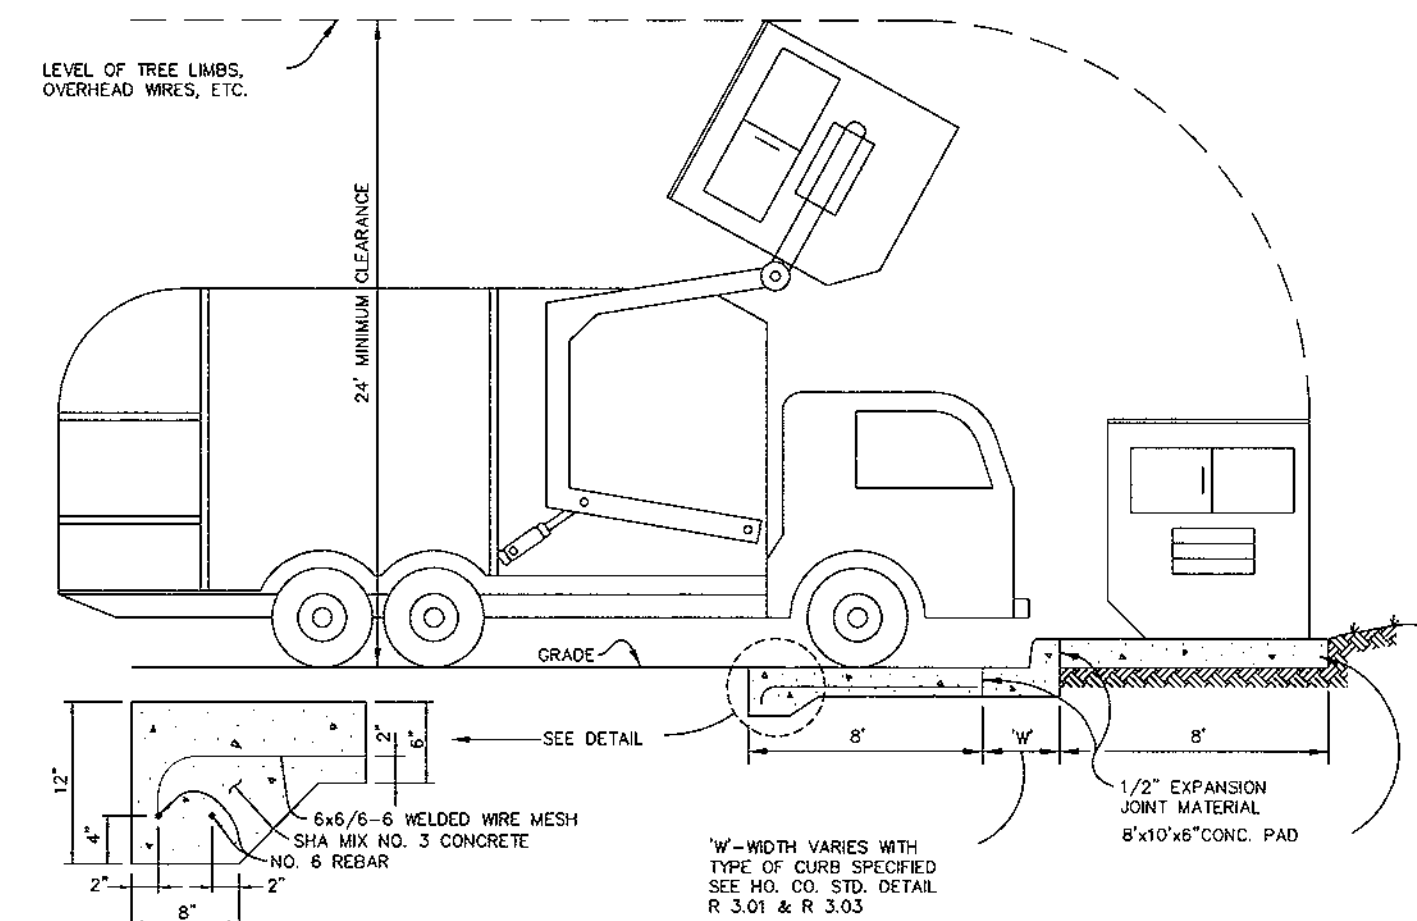


DUMPSTER PAD

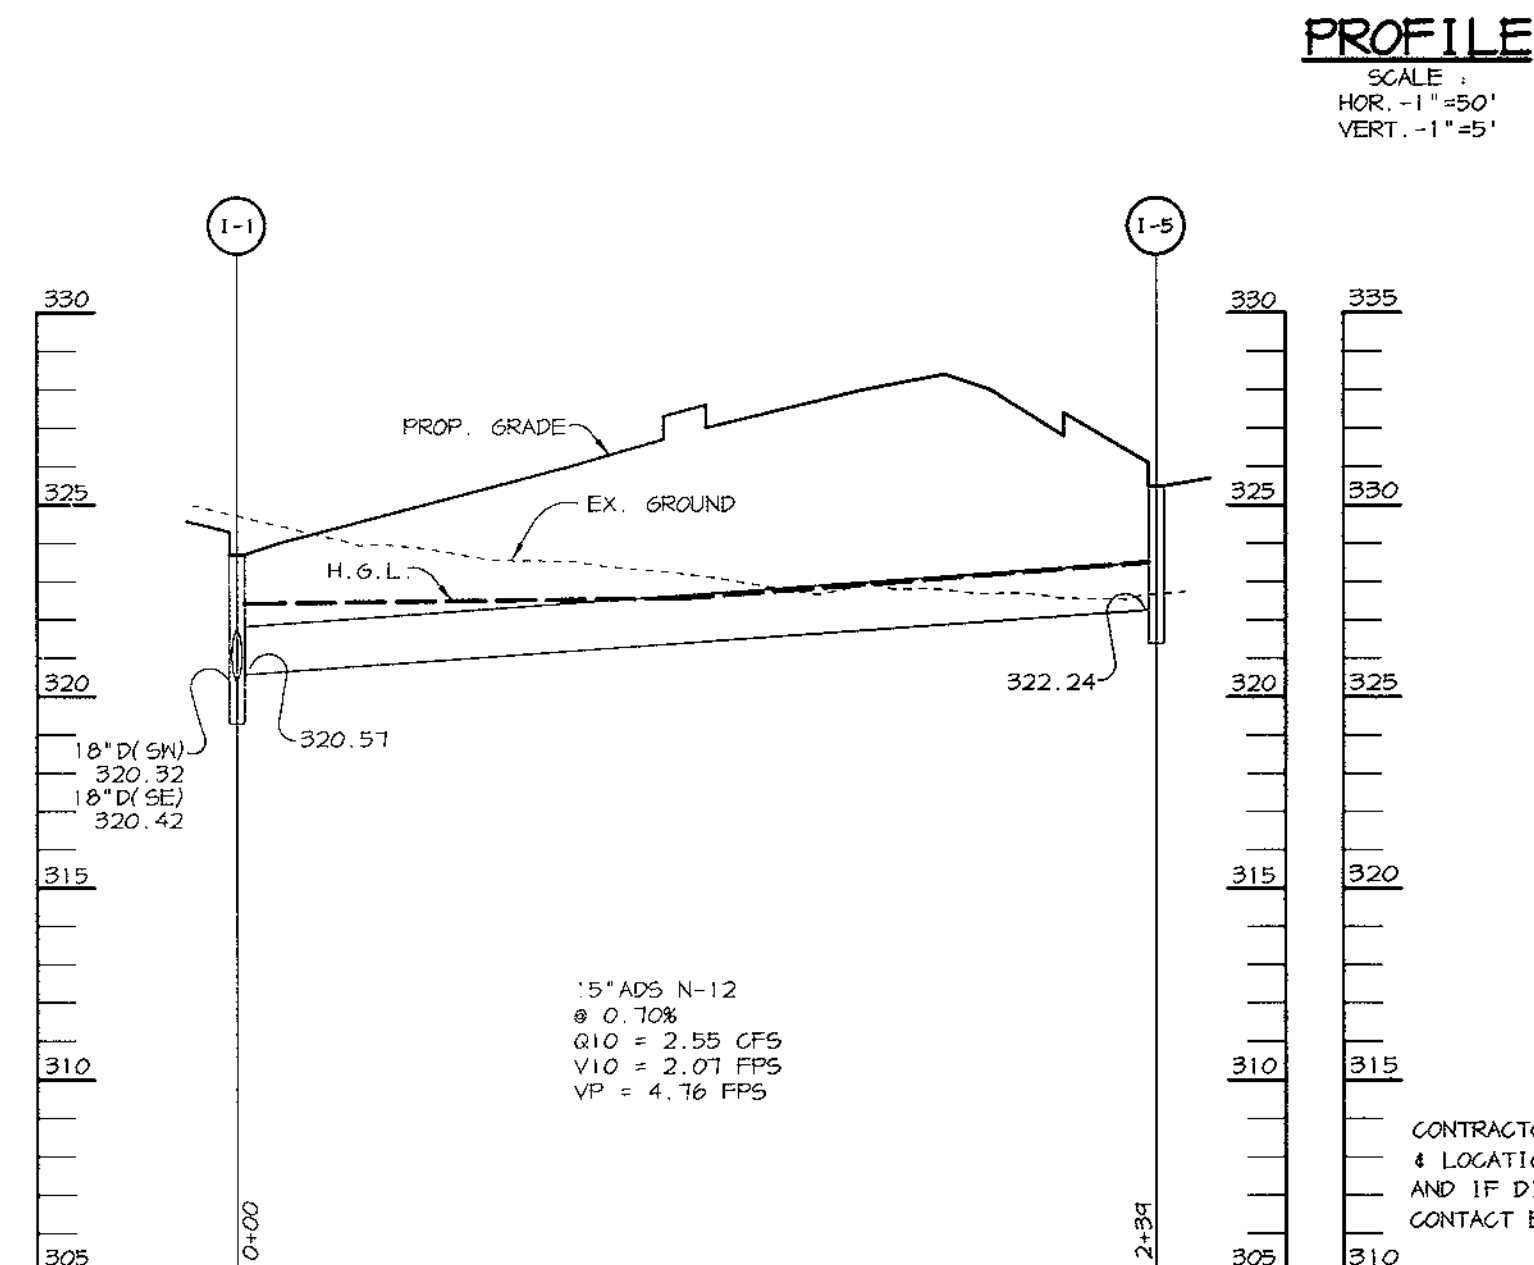



PROFILE

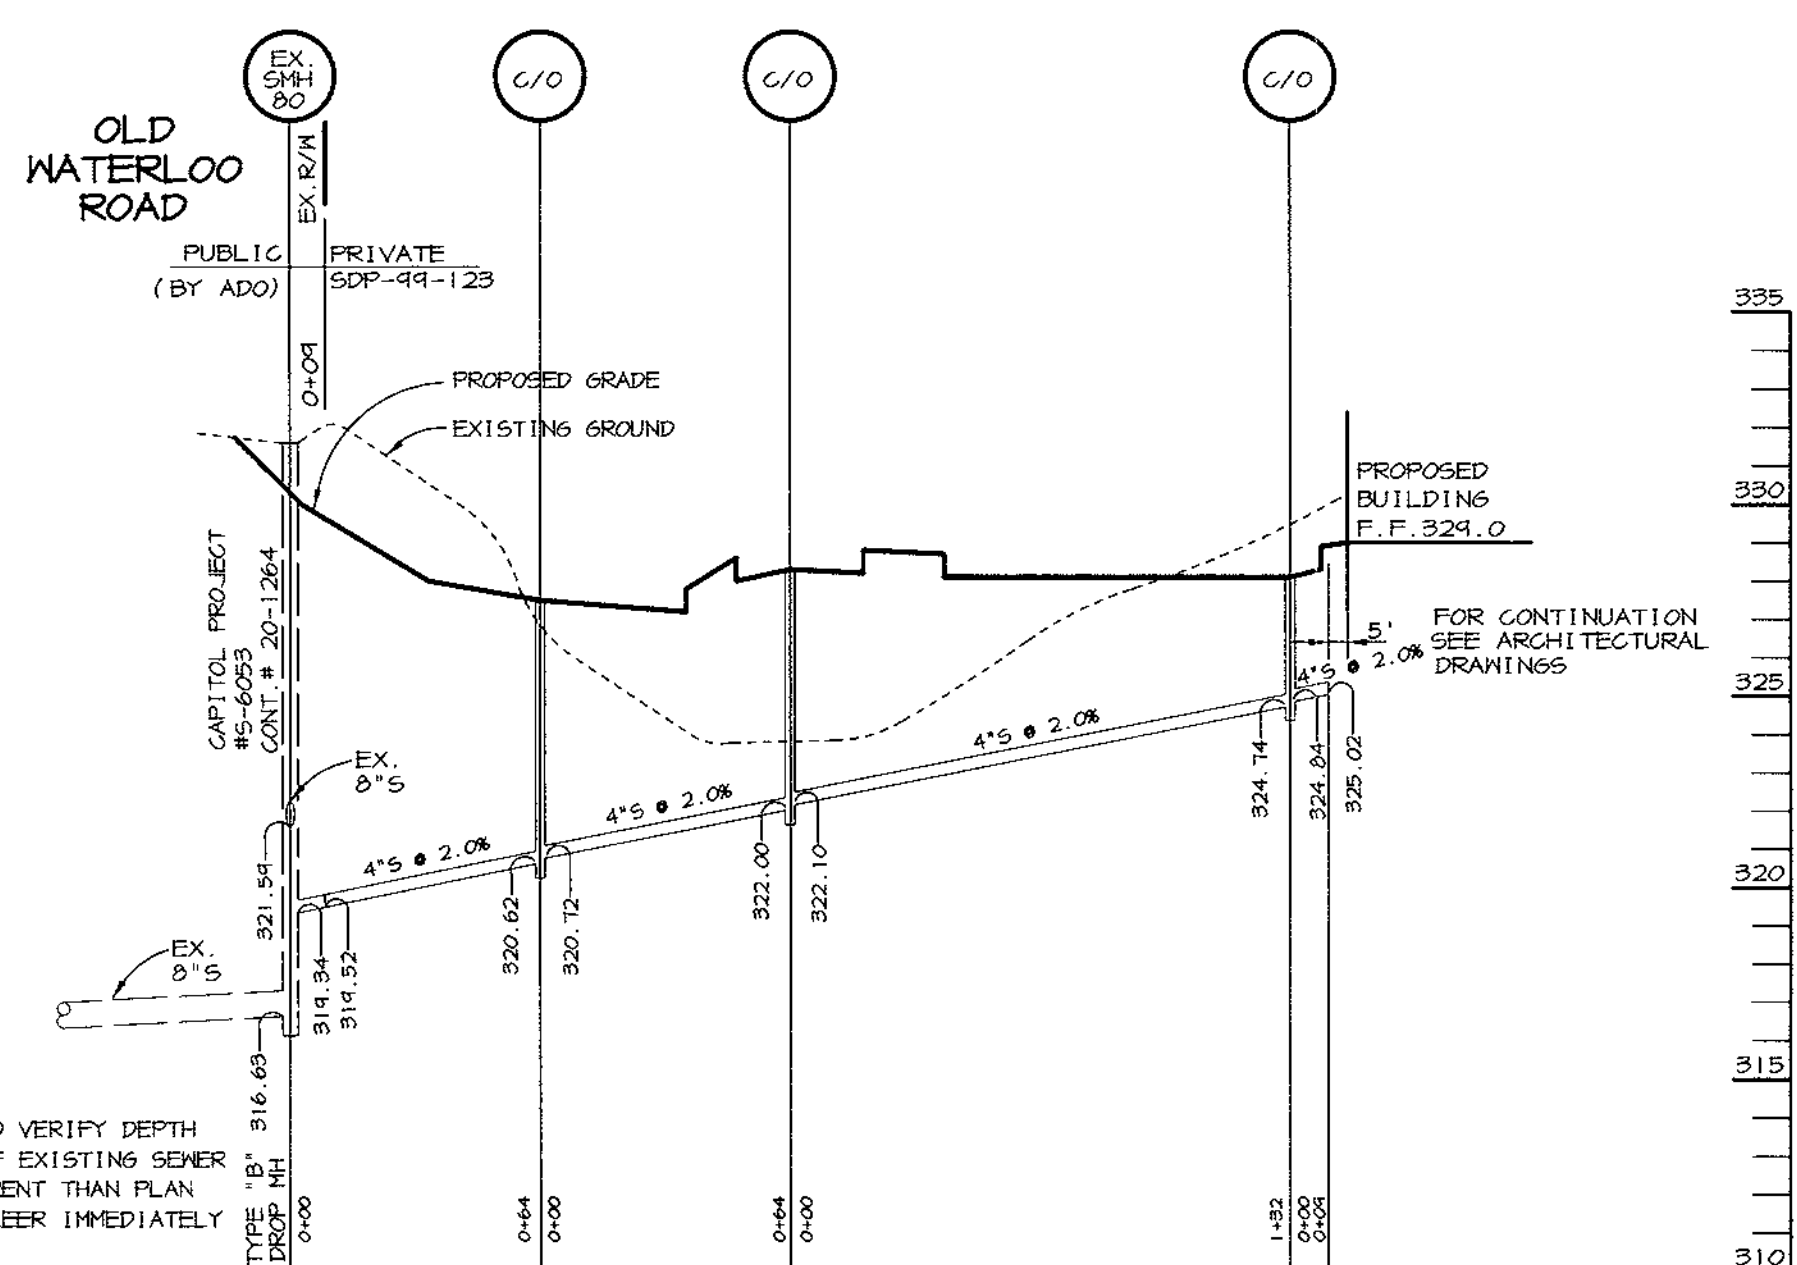


## SEWER PROFILE

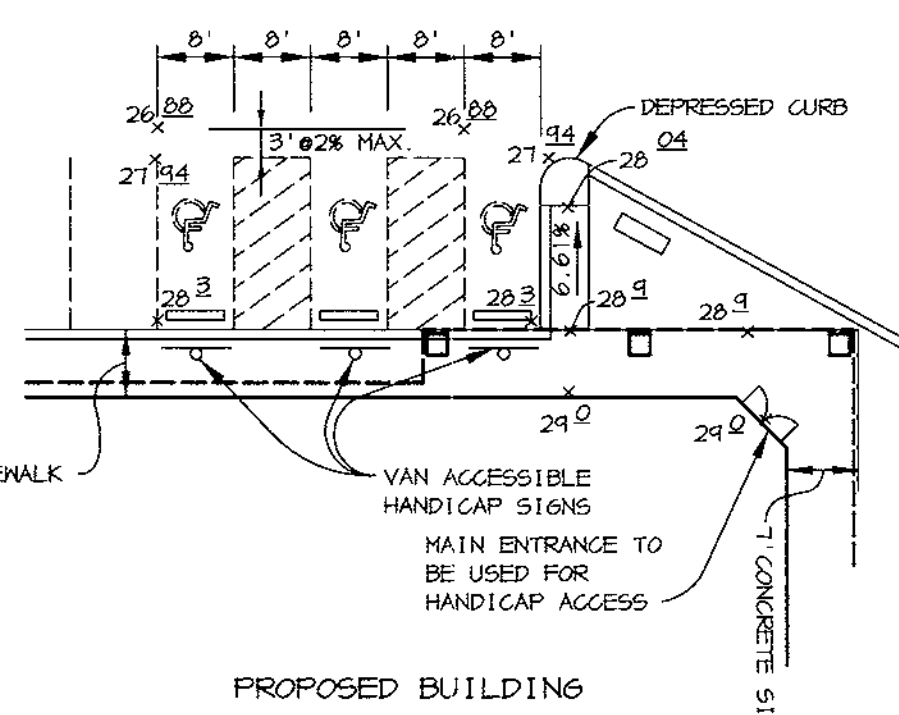

### HANDICAP RAMP DETAIL

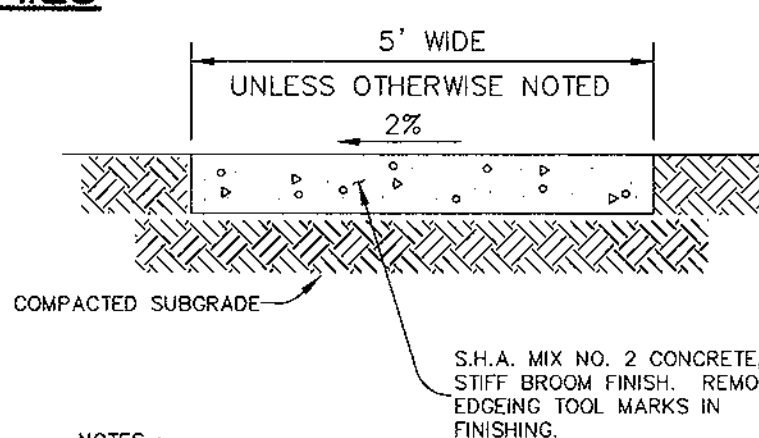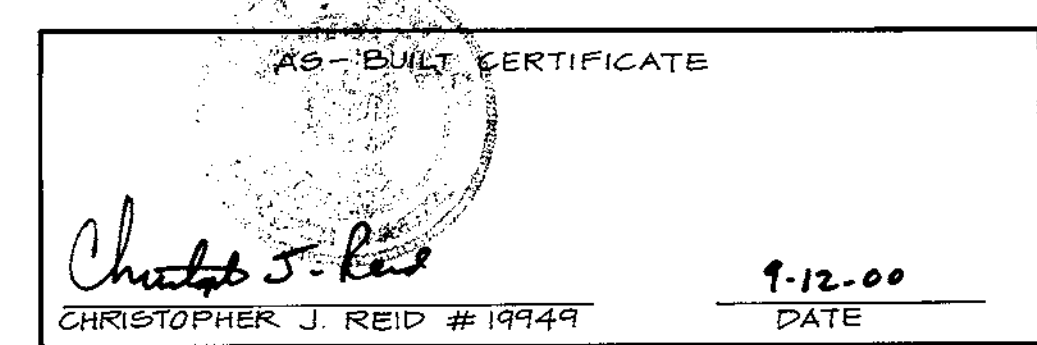

## SIDEWALK DETAIL

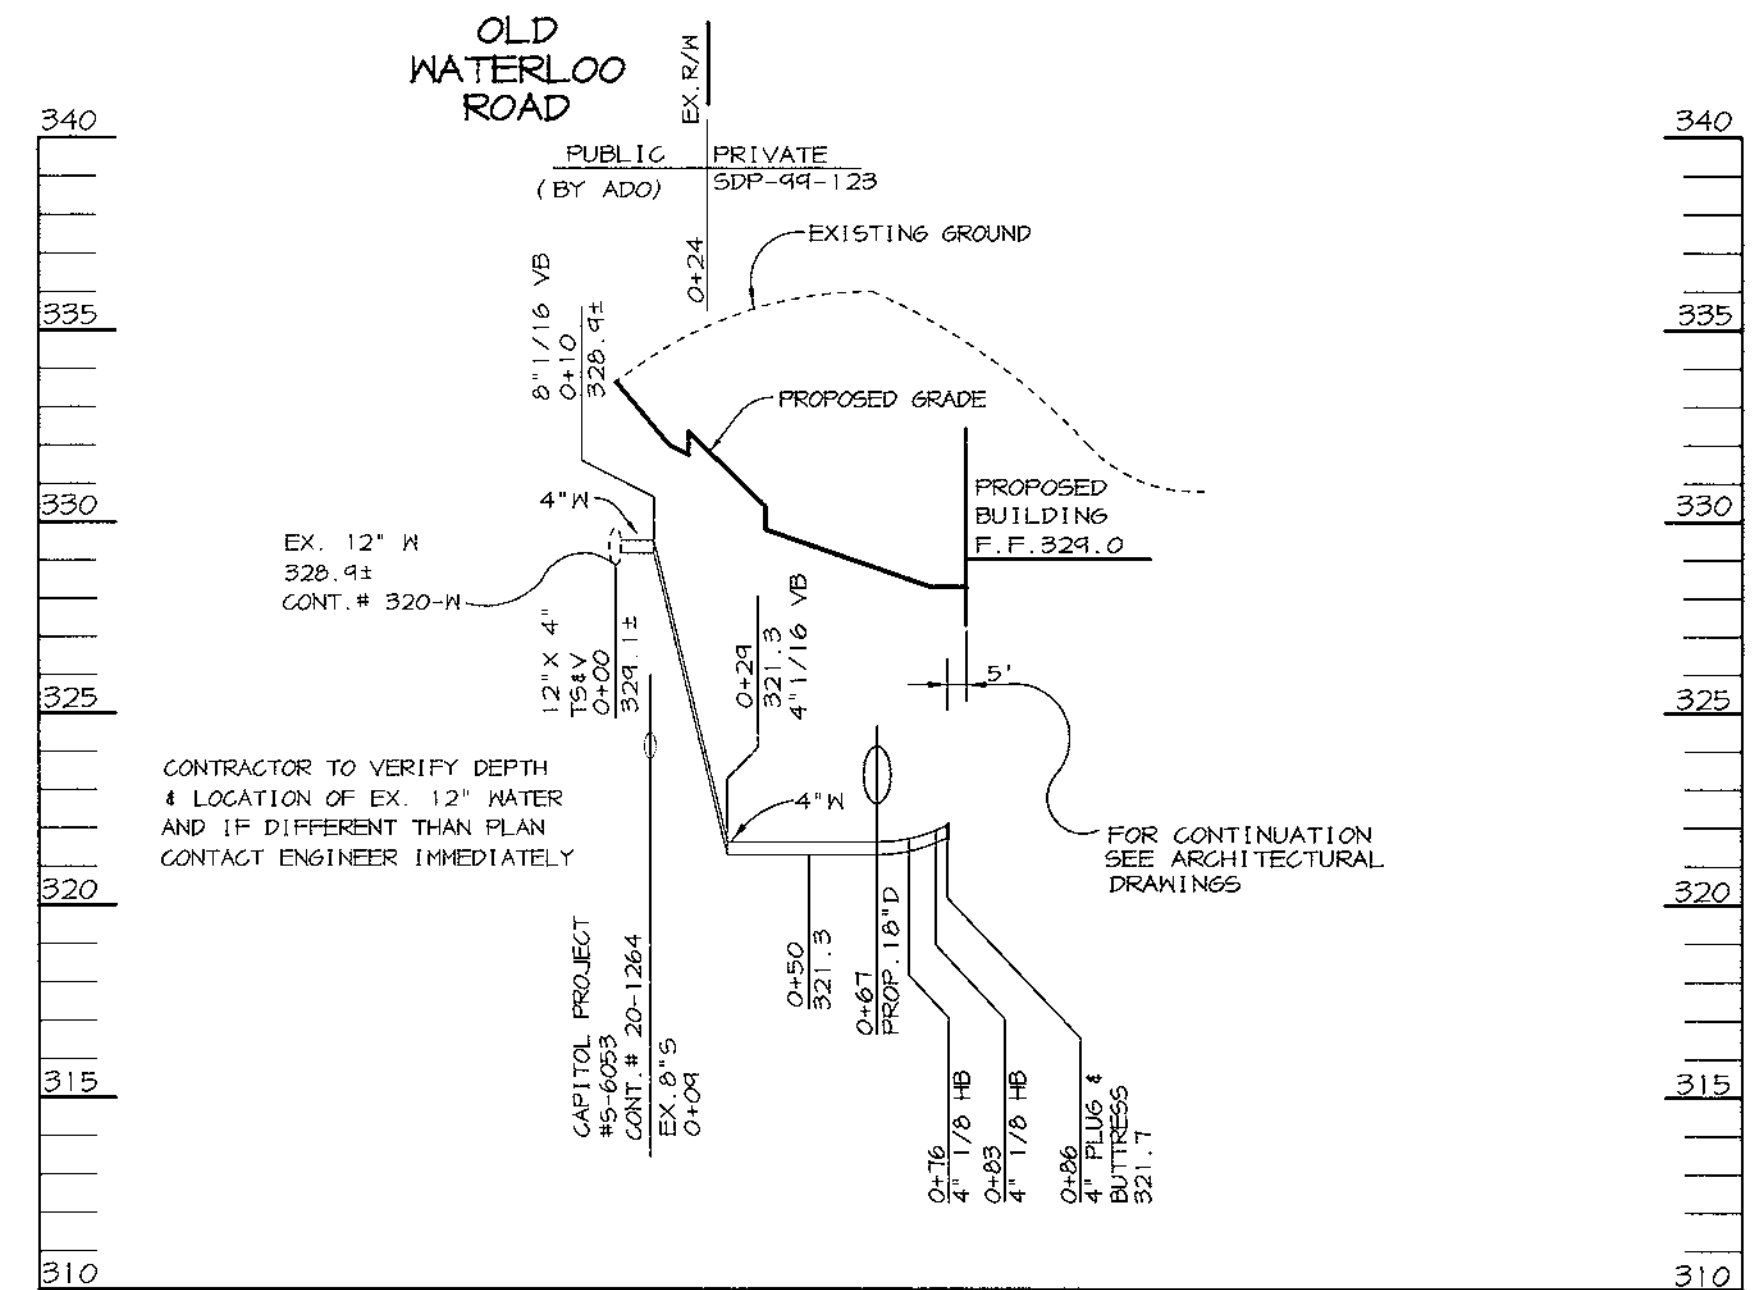

## WATER PROFILE

STRUCTURE	TYPE	LOCATION		INV. IN	INV. OUT	TOP	REMARKS
1-1	A-5	* N 555,662.33	E 1,370,537.35	320.42 (18") 320.51 (15")	320.32	324.3	HOCO STD. DETAIL SD 4.40
1-2	A-5	* N 555,637.48	E 1,370,583.04	321.03 (12") 321.03 (18")	320.93	327.2	HOCO STD. DETAIL SD 4.40
1-3	A-5	* N 555,650.33	E 1,370,644.87	322.26 (12") 322.26 (18")	322.16	328.2	HOCO STD. DETAIL SD 4.40
1-4	A-5	* N 555,769.01	E 1,370,732.78	-	323.83	327.7	HOCO STD. DETAIL SD 4.40
1-5	S-COMB	* N 555,883.53	E 1,370,621.04	-	322.24	325.5	HOCO STD. DETAIL SD 4.32
M-1	4' MH	* N 555,521	E 1,370,466	311.89	307.75	315.0	HOCO STD. DETAIL 6 5.12
M-2	4' MH	* N 555,679	E 1,370,726	323.01	322.76	328.5	HOCO STD. DETAIL 6 5.12
E-1	18" CONC. END SECTION	* N 555,427	E 1,307,462	307.00 306.88	-	-	HOCO STD. DETAIL SD 5.51
M2-1	BAW/SAVER	* N 555,625	E 1,370,518	314.42 314.53	314.55 314.55	324.95 325.05	SEE DETAIL, SHEET 7


NOTES: \* LOCATION IS AT CENTER OF THROAT OPENING AT FACE OF CURB FOR INLETS

APPROVED : FOR PUBLIC WATER AND PUBLIC SEWERAGE SYSTEMS, HOWARD COUNTY HEALTH DEPARTMENT.	
<i>Deane Matlock M.D.</i> 11/9/99 COUNTY HEALTH OFFICER <sup>MS</sup> DATE	
APPROVED : HOWARD COUNTY DEPARTMENT OF PLANNING AND ZONING.	
<i>Ly. L. Smith</i> 11/15/99 DIRECTOR <sup>bb</sup> DATE	
<i>W. D. [Signature]</i> 11/4/99 CHIEF, DEVELOPMENT ENGINEERING DIVISION 4 DATE	
<i>Wanda Hamlett</i> 11/12/99 CHIEF, DIVISION OF LAND DEVELOPMENT DATE	
DATE	NO.
REVISION	
OWNER	OWNER
AUDREY OWENS ETAL. 7533 GLENEAGLE DR. JESSUP, MD 20794 (410) 749-4655	OM HOSPITALITY MANAGEMENT, INC. 6251 WASHINGTON BLVD. ELKBRIDGE, MD 21075 (410) 379-3095

DEVELOPER	ASTON PROPERTIES 6525 MORRISON BLVD., SUITE 300 CHARLOTTE, NC 28211 (704)366-1337
PROJECT	CVS RETAIL STORE
AREA	Parcels 259 & 260 Tax Map 37 Block 14, 20 Zoned B-1, B-2 6th Election District Howard County, Maryland
TITLE	PROFILES, NOTES AND DETAILS



**RIEMER MUEGGE & ASSOCIATES INC.**  
 ENGINEERING • ENVIRONMENTAL SERVICES • PLANNING • SURVEYING  
 8818 Centre Park Drive, Columbia, MD 21045  
 tel 410.997.8900 fax 410.997.9282

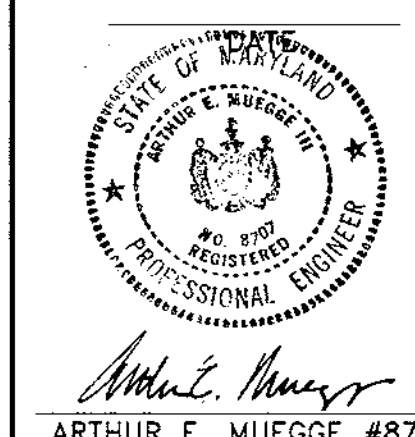

DESIGNED BY : C.J.R.
DRAWN BY : D.A.M.
PROJECT NO : 98313 SDP4.DWG
DATE : OCTOBER 13, 1999
SCALE : AS SHOWN
DRAWING NO. 4 OF 8



## TEMPORARY SEEDING NOTES

Apply to graded or cleared areas likely to be redisturbed where a short-term vegetative cover is needed.

**Seeded Preparation** - Loosen upper three inches of soil by raking, disking or other acceptable means before seeding, if not previously loosened.

**Soil Amendments** - Apply 600 lbs. per acre 10-10-10 Fertilizer (14 lbs. per 1000 sq. ft.)

**Seeding** - For periods March 1 thru April 30 and from August 15 thru November 15, seed with 2 1/2 bushels per acre of annual ryegrass (3.2 lbs. per 1000 sq. ft.). For the period May 1 thru August 14, seed with 3 lbs. per acre of creeping lovegrass (0.07 lbs. per 1000 sq. ft.). For the period November 16 thru February 28, protect site by applying 2 tons per acre of well anchored straw mulch and seed as soon as possible in the spring, or use sod.

**Mulching** - Apply 1 1/2 to 2 tons per acre (10 to 40 lbs. per 1000 sq. ft.) of unrotted small grain straw immediately after seeding. Anchor mulch immediately after application using mulch anchoring tool or 210 gal. per acre (5 gal. per 1000 sq. ft.) of emulsified asphalt on flat areas. On slopes, 8 ft. or higher, use 347 gal. per acre (8 gal. per 1000 sq. ft.) for anchoring.

Refer to the 1983 MARYLAND STANDARDS AND SPECIFICATIONS FOR SOIL EROSION AND SEDIMENT CONTROL, for rate and methods not covered.

## PERMANENT SEEDING NOTES

Apply to graded or cleared areas not subject to immediate further disturbance where a permanent long-lived vegetative cover is needed.

**Seeded Preparation** - Loosen upper three inches of soil by raking, disking or other acceptable means before seeding, if not previously loosened.

**Soil Amendments** - In lieu of soil test recommendations, use one of the following schedules:

- 1) Preferred - Apply 2 tons per acre dolomitic limestone (92 lbs. per 1000 sq. ft.) and 600 lbs. per acre 10-10-10 fertilizer (14 lbs. per 1000 sq. ft.) before seeding. Harrow or disc into upper three inches of soil. At time of seeding, apply 400 lbs. per acre 30-0-0 ureaform fertilizer (4 lbs. per 1000 sq. ft.).
- 2) Acceptable - Apply 2 tons per acre dolomitic limestone (92 lbs. per 1000 sq. ft.) and 1000 lbs. per acre 10-10-10 fertilizer (23 lbs. per 1000 sq. ft.) before seeding. Harrow or disc into upper three inches of soil.

**Seeding** - For the period March 1 thru April 30 and from August 1 thru October 15, seed with 60 lbs. per acre (1.4 lbs. per 1000 sq. ft.) of Kentucky 31 Tall Fescue. For the period May 1 thru July 31, seed with 60 lbs. per acre (1.4 lbs. per 1000 sq. ft.) of Kentucky 31 Tall Fescue per acre and 2 lbs. per acre (0.05 lbs. per 1000 sq. ft.) of creeping lovegrass. During the period October 16 thru February 28, protect site by one of the following options:

- 1) 2 tons per acre of well-anchored mulch straw and seed as soon as possible in the spring.
- 2) Use sod.
- 3) Seed with 60 lbs. per acre Kentucky 31 Tall Fescue and mulch with 2 tons per acre well anchored straw.

**Mulching** - Apply 1 1/2 to 2 tons per acre (10 to 40 lbs. per 1000 sq. ft.) of unrotted small grain straw immediately after seeding. Anchor mulch immediately after application using mulch anchoring tool or 210 gal. per acre (5 gal. per 1000 sq. ft.) of emulsified asphalt on flat areas. On slopes, 8 ft. or higher, use 347 gal. per acre (8 gal. per 1000 sq. ft.) for anchoring.

**Maintenance** - Inspect all seeded areas and make needed repairs, replacements and reseedings.

## SEDIMENT CONTROL NOTES

1. A MINIMUM OF 48 HOURS NOTICE MUST BE GIVEN TO THE HOWARD COUNTY DEPARTMENT OF INSPECTIONS, LICENSES, AND PERMITS, SEDIMENT CONTROL DIVISION PRIOR TO THE START OF ANY CONSTRUCTION (319-1855).

2. ALL VEGETATIVE AND STRUCTURAL PRACTICES ARE TO BE INSTALLED ACCORDING TO THE PROVISIONS OF THIS PLAN AND ARE TO BE IN CONFORMANCE WITH THE 1984 MARYLAND STANDARDS AND SPECIFICATIONS FOR SOIL EROSION AND SEDIMENT CONTROL AND REVISIONS THERETO.

3. FOLLOWING INITIAL SOIL DISTURBANCE OR RE-DISTURBANCE, PERMANENT OR TEMPORARY STABILIZATION SHALL BE COMPLETED WITHIN A 7 CALENDAR DAYS FOR ALL PERIMETER SEDIMENT CONTROL STRUCTURES, DIKES, PERIMETER SLOPES, AND ALL SLOPES STEEPER THAN 3:1. B) 14 DAYS AS TO ALL OTHER DISTURBED OR GRADED AREAS ON THE PROJECT SITE.

4. ALL SEDIMENT TRAPS/BASINS SHOWN MUST BE FENCED AND WARNING SIGNS POSTED AROUND THE PERIMETER IN ACCORDANCE WITH VOL. 1, CHAPTER 7, OF THE HOWARD COUNTY DESIGN MANUAL, STORM DRAINAGE.

5. ALL DISTURBED AREAS MUST BE STABILIZED WITHIN THE TIME PERIOD SPECIFIED ABOVE IN ACCORDANCE WITH THE 1984 MARYLAND STANDARDS AND SPECIFICATIONS FOR SOIL EROSION AND SEDIMENT CONTROL, FOR PERMANENT SEEDING, SOD, TEMPORARY SEEDING, AND MULCHING (SEC. 6.). TEMPORARY STABILIZATION WITH MULCH ALONE SHALL ONLY BE DONE WHEN RECOMMENDED SEEDING DATES DO NOT ALLOW FOR PROPER GERMINATION AND ESTABLISHMENT OF GRASSES.

6. ALL SEDIMENT CONTROL STRUCTURES ARE TO REMAIN IN PLACE AND ARE TO BE MAINTAINED IN OPERATIVE CONDITION UNTIL PERMISSION FOR THEIR REMOVAL HAS BEEN OBTAINED FROM THE HOWARD COUNTY SEDIMENT CONTROL INSPECTOR.

7. SITE ANALYSIS:

TOTAL AREA OF SITE	1.54 ACRES
AREA DISTURBED	2.3 ACRES
AREA TO BE ROOFED OR PAVED	1.2 ACRES
AREA TO BE VEGETATIVELY STABILIZED	1.1 ACRES
TOTAL CUT	7514 CU. YARDS
TOTAL FILL	1450 CU. YARDS
OFFSITE WASTE/BORROW AREA LOCATION TO HAVE AN EROSION GRADING PERMIT	

8. ANY SEDIMENT CONTROL PRACTICE WHICH IS DISTURBED BY GRADING ACTIVITY FOR PLACEMENT OF UTILITIES MUST BE REPAIRED ON THE SAME DAY OF DISTURBANCE.

9. ADDITIONAL SEDIMENT CONTROLS MUST BE PROVIDED, IF DEEMED NECESSARY BY THE HOWARD COUNTY SEDIMENT CONTROL INSPECTOR.

10. SITE GRADING WILL BEGIN ONLY AFTER ALL PERIMETER SEDIMENT CONTROL MEASURES HAVE BEEN INSTALLED AND ARE IN A FUNCTIONING CONDITION.

11. SEDIMENT WILL BE REMOVED FROM TRAPS WHEN ITS DEPTH REACHES CLEAN OUT ELEVATION SHOWN ON THE PLANS.

12. CUT AND FILL QUANTITIES PROVIDED UNDER SITE ANALYSIS DO NOT REPRESENT BID QUANTITIES. THESE QUANTITIES DO NOT DISTINGUISH BETWEEN TOPSOIL, STRUCTURAL FILL, OR EMBANKMENT MATERIAL. NOR DO THEY REFLECT CONSIDERATION OF UNDERCUTTING OR REMOVAL OF UNSUITABLE MATERIAL. THE CONTRACTOR SHALL FAMILIARIZE HIMSELF WITH SITE CONDITIONS WHICH MAY AFFECT THE WORK.

13. ON ALL SITES WITH DISTURBED AREAS IN EXCESS OF 2 AC., APPROVAL OF THE INSPECTION AGENCY SHALL BE REQUESTED UPON COMPLETION OF INSTALLATION OF PERIMETER EROSION AND SEDIMENT CONTROLS. BUT BEFORE PROCEEDING WITH ANY OTHER EARTH DISTURBANCE OR GRADING. OTHER BUILDINGS OR GRADINGS INSPECTION APPROVALS MAY NOT BE AUTHORIZED UNTIL THIS INITIAL APPROVAL BY THE INSPECTION AGENCY IS MADE.

14. TRENCHES FOR THE CONSTRUCTION OF UTILITIES IS LIMITED TO THREE PIPE LENGTHS OR THAT WHICH CAN BE BACKFILLED AND STABILIZED WITHIN ONE WORKING DAY, WHICHEVER IS SHORTER.

## MD-378 STANDARDS AND SPECIFICATIONS

### SPECIFICATIONS

These specifications are appropriate to all ponds within the scope of the Standard for practice MD-378. All references to ASTM and AASHTO specifications apply to the most recent version.

### SITE PREPARATION

Areas designated for borrow areas, embankment, and structural works shall be cleared, grubbed and stripped of topsoil. All trees, vegetation, roots and other objectionable material shall be removed. Channel banks and sharp breaks shall be sloped to no steeper than 1:1.

Areas to be covered by the reservoir will be cleared of all trees, brush, logs, fences, rubbish and other objectionable material unless otherwise designated on the plans. Trees, brush and stumps shall be cut approximately level with the ground surface. For dry stormwater management ponds, a minimum of a 50 foot radius around the inlet structure shall be disposed of outside and below the limits of the dam and reservoir as directed by the owner or his representative. When specified, a sufficient quantity of topsoil will be stockpiled in a suitable location for use on the embankment and other designated areas.

### EARTH FILL

Material - The fill material shall be taken from approved designated borrow areas. It shall be free of roots, stumps, wood, rubbish, stones greater than 6", frozen or other objectionable material. Fill material for the center of the embankment and cut off trench shall conform to Unified Soil Classification G, SC, SH, or CL. Consideration may be given to the use of other materials in the embankment if design and construction are supervised by a geotechnical engineer.

Placement - Areas on which fill is to be placed shall be scarified prior to placement of fill. Fill materials shall be placed in maximum 8-inch thick (before compaction) layers which are to be continuous over the entire length of the fill. The most permeable borrow material shall be placed in the downstream portions of the embankment. The principal spillway must be installed concurrently with fill placement and not excavated into the embankment.

Compaction - The movement of the hauling and spreading equipment over the fill shall be controlled so that the entire surface of each lift shall be traversed by not less than one tread track of the equipment or compaction shall be achieved by a minimum of 10 passes of a sheepsfoot roller or vibratory roller. Fill material shall contain sufficient moisture such that the required degree of compaction will be obtained with the equipment used. The fill material shall contain sufficient moisture so that if formed into a ball it will not crumble yet not be so wet that water can be squeezed out.

Where a minimum required density is specified, it shall not be less than 95% of maximum dry density with a moisture content within +/- 2% of the optimum. Each layer of fill shall be compacted as necessary to obtain that density, and is to be certified by the Engineer at the time of construction. All compaction is to be determined by AASHTO Method T-99.

Cutoff Trench - The cutoff trench shall be excavated into impervious material along or parallel to the centerline of the embankment as shown on the plans. The bottom width of the trench shall be governed by the equipment used for excavation, with the minimum width being four feet. The depth shall be at least four feet below existing grade or as shown on the plans. The side slopes of the trench shall be 1 to 1 or flatter.

The back fill shall be compacted with construction equipment, rollers, or hand tools to assure maximum density and minimum permeability.

### STRUCTURE BACKFILL

Backfill adjacent to pipes or structures shall be of the type and quality conforming to that specified for the adjoining fill material. The fill shall be placed in horizontal layers not to exceed four inches in thickness and compacted by hand tampers or other manually directed compaction equipment. The material needs to fill completely all spaces under and adjacent to the pipe. At no time during the backfilling operation shall driven equipment be allowed to operate closer than four feet, measured horizontally, to any part of a structure. Under no circumstances shall equipment be driven over any part of a concrete structure or pipe, unless there is a compacted fill of 24" or greater over the structure or pipe.

### PIPE CONDUITS

All pipes shall be circular in cross section.

Reinforced Concrete Pipe - All of the following criteria shall apply for reinforced concrete pipe:

1. Materials - Reinforced concrete pipe shall have bell and spigot joints with rubber gaskets and shall equal or exceed ASTM Designation C-361. An approved equivalent is AWWA Specification C-302.
2. Bedding - All reinforced concrete pipe conduits shall be laid in a concrete bedding for their entire length. This bedding shall consist of high strength concrete placed under the pipe and up the side of the pipe at least 10% of its outside diameter with a minimum thickness of 3 inches, or as shown on the drawings.
3. Laying pipe - Bell and spigot pipe shall be placed with the bell and upstream. Joints shall be made in accordance with recommendations of the manufacturer of the material. After the joints are sealed for the entire line, the bedding shall be placed so that all spaces under the pipe are filled. Care shall be exercised to prevent any deviation from the original line and grade of the pipe. The first joint must be located within 2 feet from the riser.
4. Backfilling shall conform to Structure Backfill.
5. Other details (anti-seep collars, valves, etc.) shall be as shown on the drawings.

### CONCRETE

Concrete shall meet the requirements of Maryland Department of Transportation, State Highway Administration Standard Specifications for Construction and Materials, Section 608, Mix No. 3.

### ROCK RIPRAP

All rock shall be dense, sound, and free from cracks, seams, and other defects conducive to accelerated weathering. The rock fragments shall be angular to subrounded in shape. The least dimension of an individual rock fragment shall be not less than one-third the greatest dimension of the fragment.

The rock shall have the following properties:

1. Bulk specific gravity (saturated surface-dry basis) not less than 2.5.
2. Absorption not more than three percent.
3. Soundness: Weight loss in five cycles not more than 20 percent when sodium sulfate is used.

Bulk specific gravity and absorption shall be determined according to ASTM C 127. The test for soundness shall be performed according to ASTM C 88.

The riprap shall be placed to the required thickness in one operation. The rock shall be delivered and placed in a manner that will insure the riprap in place shall be reasonably homogeneous with the larger rocks uniformly distributed and firmly in contact one to another with the smaller rocks filling the voids between the larger rocks. Filter cloth shall be placed under all riprap and shall meet the requirements of Maryland Department of Transportation, State Highway Administration Standard Specifications for Construction and Materials, Section 919.12.

### CARE OF WATER DURING CONSTRUCTION

All work on permanent structures shall be carried out in areas free from water. The Contractor shall construct and maintain all temporary dikes, levees, cofferdams, drainage channels, and storm diversions necessary to protect the areas to be occupied by the permanent work. The contractor shall also furnish, install, operate, and maintain all necessary pumping and other equipment required for removal of water from the various parts of the work and for maintaining the excavations, foundation, and other parts of the work free from water as required or directed by the engineer for constructing each part of the work. After having served their purpose, all temporary protective works shall be removed or leveled and graded to the extent required to prevent obstruction in any degree whatsoever of the flow of water to the spillway or outlet works and so as not to interfere in any way with the operation or maintenance of the structure. Storm diversions shall be maintained until the full flow can be passed through the permanent works. The removal of water from the required excavation and the foundation shall be accomplished in a manner and to the extent that will maintain stability of the excavated slopes and bottom of required excavations and will allow satisfactory performance of all construction operations. During the placing and compacting of material in required excavations, the water level at the locations being refilled shall be maintained at or below the bottom of the excavation. Locations which may require draining the water to pumps from which the water shall be pumped.

### STABILIZATION


All borrow areas shall be graded to provide proper drainage and left in a highly condition. All exposed surfaces of the embankment, spillway, and borrow areas, and berms shall be stabilized by seeding, liming, fertilizing and mulching in accordance with the Maryland Soil Conservation Service Standards and Specifications for Critical Area Planting (MD-342) or as shown on the accompanying drawings.

### EROSION AND SEDIMENT CONTROL

Construction operations will be carried out in such a manner that erosion will be controlled and water and air pollution minimized. State and local laws concerning pollution abatement will be followed. Construction plans shall detail erosion and sediment control measures to be employed during the construction process.


Refer to the 1984 MARYLAND STANDARDS AND SPECIFICATIONS FOR SOIL EROSION AND SEDIMENT CONTROL, for rate and methods not covered.

## DETAIL 22 - SILT FENCE

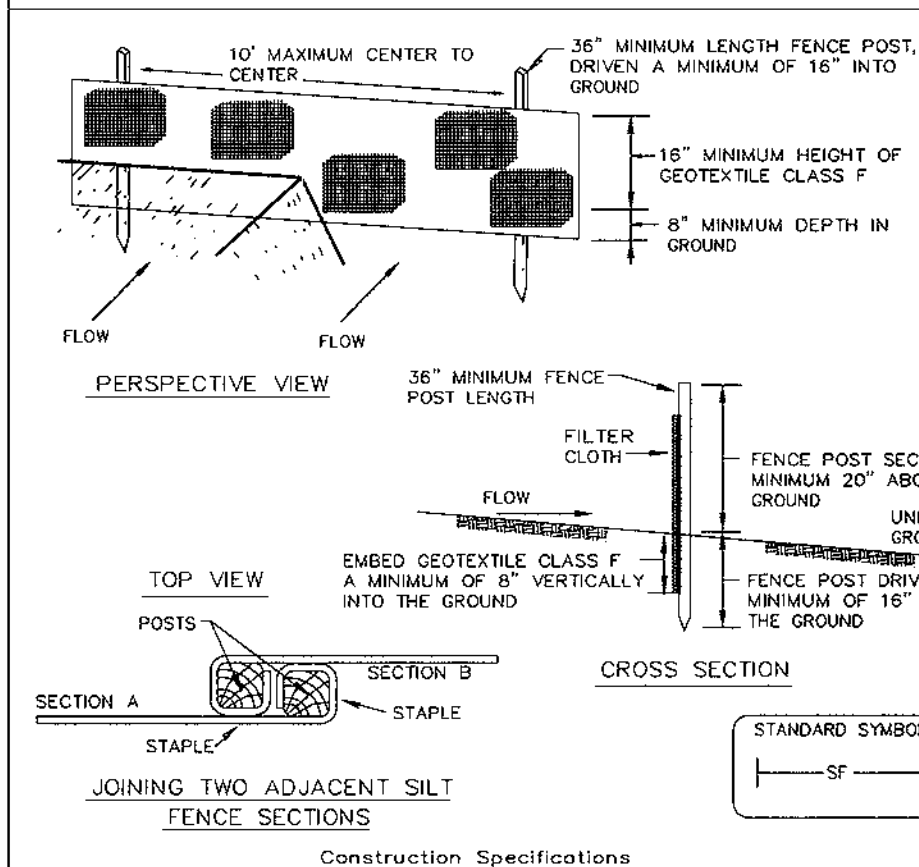


Tensile Strength		50 lbs./in. (min.)	Test: MSMT 509
Tensile Modulus		20 lbs./in. (min.)	Test: MSMT 509
Flow Rate		0.3 gal./ft. / minute (max.)	Test: MSMT 522
Filtering Efficiency		75% (min.)	Test: MSMT 322

U.S. DEPARTMENT OF AGRICULTURE SOIL CONSERVATION SERVICE	PAGE E - 16 - 3	MARYLAND DEPARTMENT OF ENVIRONMENT WATER MANAGEMENT ADMINISTRATION
---	--------------------	---

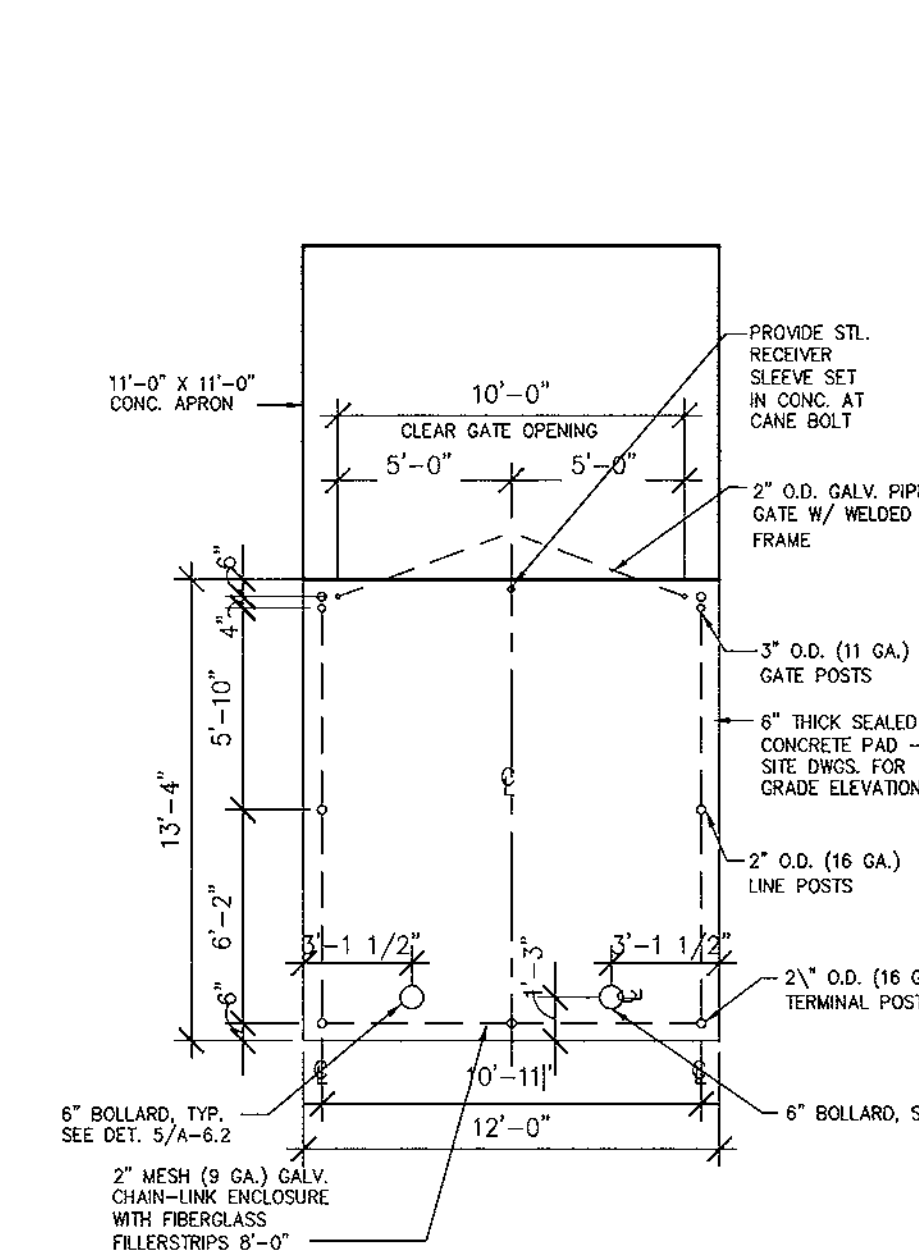


## TRASH ENCLOSURE PLAN

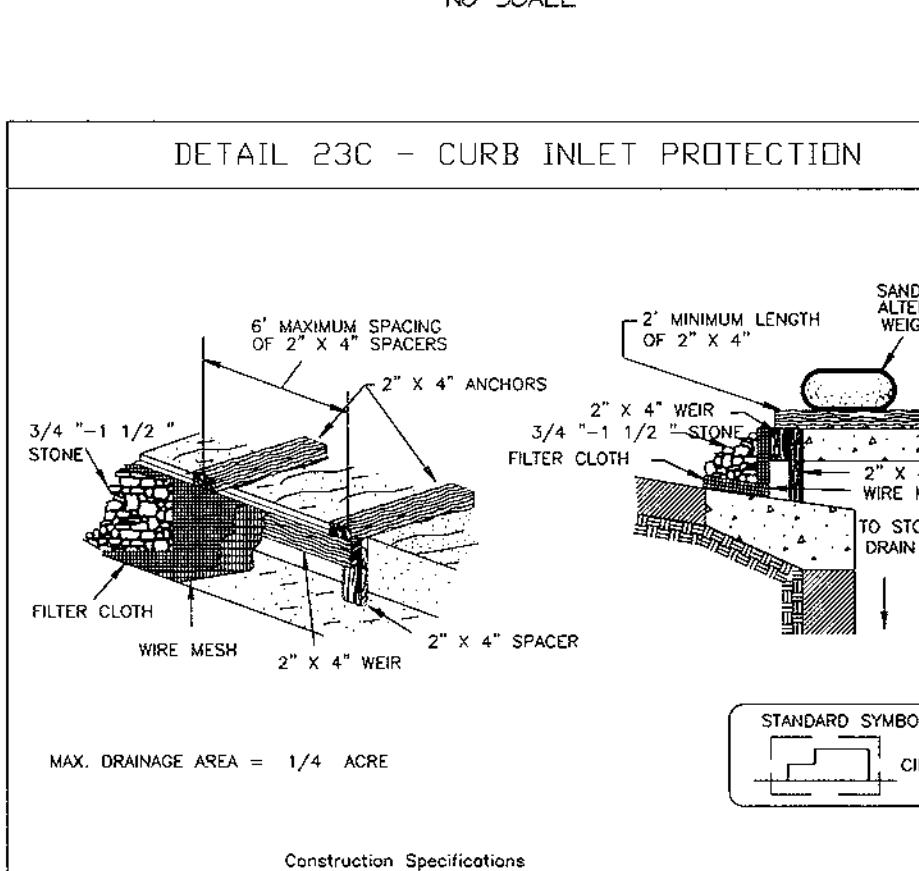

Tensile Strength		50 lbs./in. (min.)	Test: MSMT 509
Tensile Modulus		20 lbs./in. (min.)	Test: MSMT 509
Flow Rate		0.3 gal./ft. / minute (max.)	Test: MSMT 522
Filtering Efficiency		75% (min.)	Test: MSMT 322


U.S. DEPARTMENT OF AGRICULTURE SOIL CONSERVATION SERVICE	PAGE E - 16 - 3	MARYLAND DEPARTMENT OF ENVIRONMENT WATER MANAGEMENT ADMINISTRATION
---	--------------------	---

## DETAIL 24 - STABILIZED CONSTRUCTION ENTRANCE

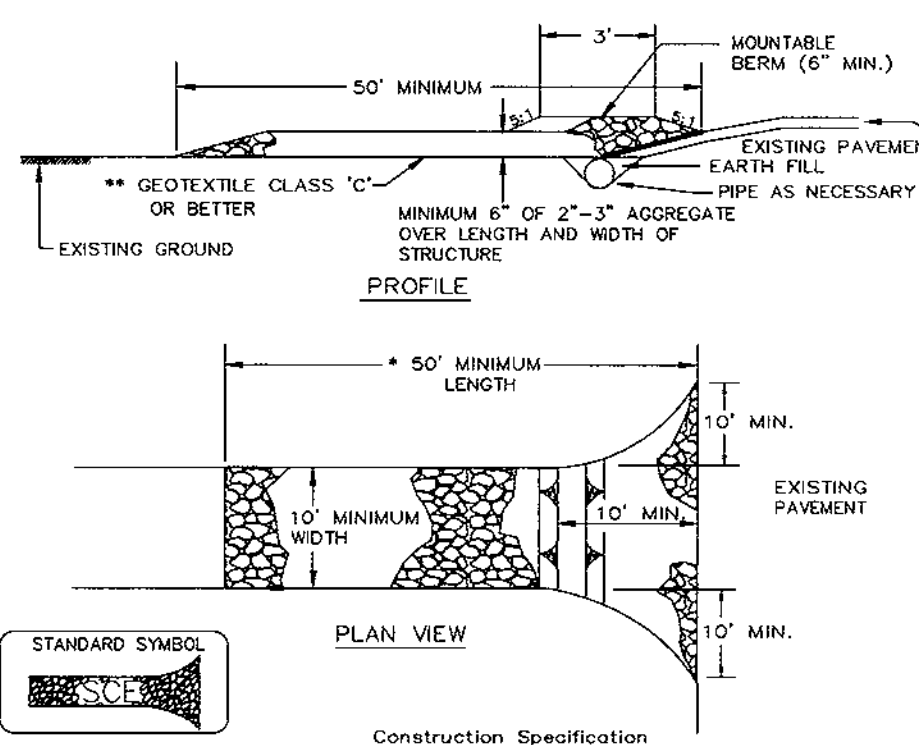


1. Length - minimum of 50' (*30' for single residence lot).	3. Geotextile fabric (filter cloth) shall be placed over the existing ground prior to placing stone. **The plan approval authority may not require single family residences to use geotextiles.
2. Width - 10' minimum; should be flared at the existing road to provide a turning radius.	4. Stone - crushed aggregate (2\"/>

U.S. DEPARTMENT OF AGRICULTURE SOIL CONSERVATION SERVICE	PAGE F - 17 - 3	MARYLAND DEPARTMENT OF ENVIRONMENT WATER MANAGEMENT ADMINISTRATION
---	--------------------	---

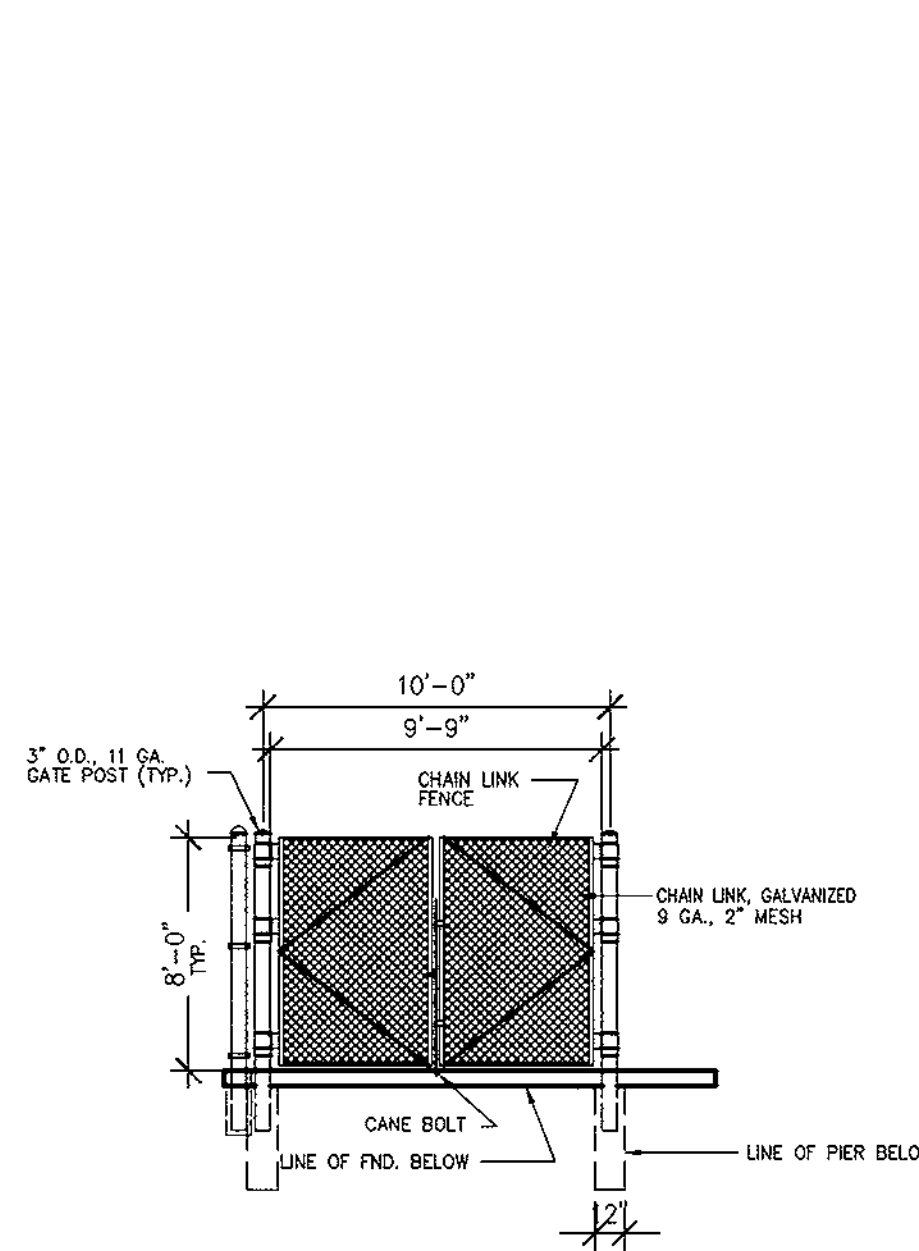

## GATE ELEVATION

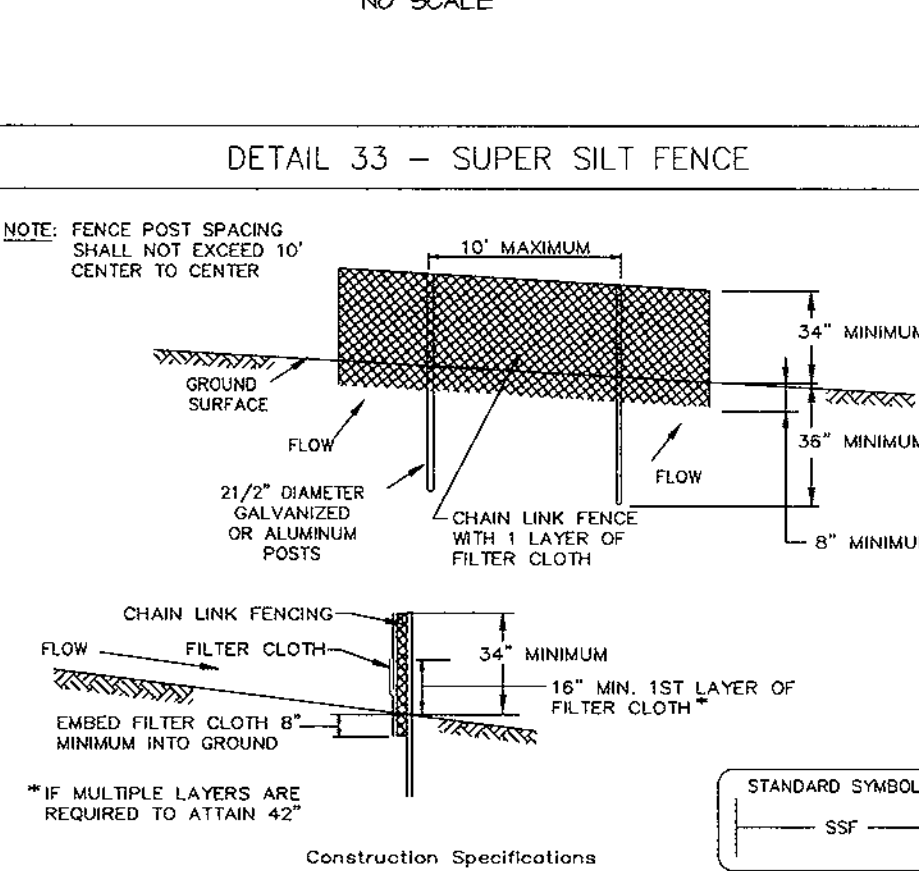


Tensile Strength		50 lbs./in. (min.)	Test: MSMT 509
Tensile Modulus		20 lbs./in. (min.)	Test: MSMT 509
Flow Rate		0.3 gal./ft. / minute (max.)	Test: MSMT 522
Filtering Efficiency		75% (min.)	Test: MSMT 322

U.S. DEPARTMENT OF AGRICULTURE SOIL CONSERVATION SERVICE	PAGE F - 17 - 3	MARYLAND DEPARTMENT OF ENVIRONMENT WATER MANAGEMENT ADMINISTRATION
---	--------------------	---

BY THE DEVELOPER :  1/WE CERTIFY THAT ALL DEVELOPMENT AND/OR CONSTRUCTION WILL BE DONE ACCORDING TO THESE PLANS, AND THAT ANY RESPONSIBLE PERSONNEL INVOLVED IN THE CONSTRUCTION PROJECT WILL HAVE CERTIFICATE ATTENDANCE AT A DEPARTMENT OF THE ENVIRONMENT APPROVED TRAINING PROGRAM FOR THE CONTROL OF SEDIMENT AND EROSION BEFORE BEGINNING THE PROJECT. I SHALL ENGAGE A REGISTERED PROFESSIONAL ENGINEER TO SUPERVISE POND CONSTRUCTION AND, PROVIDE THE HOWARD SOIL CONSERVATION DISTRICT WITH AN "AS-BUILT" PLAN OF THE POND WITHIN 30 DAYS OF COMPLETION. I ALSO AUTHORIZE PERIODIC ON-SITE INSPECTIONS BY THE HOWARD SOIL CONSERVATION DISTRICT.	
DEVELOPER  10.7.99 DATE	BY THE ENGINEER :  I CERTIFY THAT THIS PLAN FOR POND CONSTRUCTION, EROSION AND SEDIMENT CONTROL REPRESENTS A PRACTICAL AND WORKABLE PLAN BASED ON MY PERSONAL KNOWLEDGE OF THE SITE CONDITIONS. THIS PLAN WAS PREPARED IN ACCORDANCE WITH THE REQUIREMENTS OF THE HOWARD SOIL CONSERVATION DISTRICT. I HAVE NOTIFIED THE DEVELOPER THAT HE/SHE MUST ENGAGE A REGISTERED PROFESSIONAL ENGINEER TO SUPERVISE POND CONSTRUCTION AND PROVIDE THE HOWARD SOIL CONSERVATION DISTRICT WITH AN "AS-BUILT" PLAN OF THE POND WITHIN 30 DAYS OF COMPLETION.
ENGINEER  8.6.99 DATE	THESE PLANS HAVE BEEN REVIEWED FOR THE HOWARD SOIL CONSERVATION DISTRICT AND MEET THE TECHNICAL REQUIREMENTS FOR SMALL POND CONSTRUCTION, SOIL EROSION AND SEDIMENT CONTROL.
NATURAL RESOURCES CONSERVATION SERVICE 1/2/99 DATE	
THESE PLANS FOR SMALL POND CONSTRUCTION, SOIL EROSION AND SEDIMENT CONTROL MEET THE REQUIREMENTS OF THE HOWARD SOIL CONSERVATION DISTRICT.	
HOWARD SOIL CONSERVATION DISTRICT 1/2/99 DATE	
APPROVED : FOR PUBLIC WATER AND PUBLIC SEWERAGE SYSTEMS, HOWARD COUNTY HEALTH DEPARTMENT.  11/9/99 DATE	
APPROVED : HOWARD COUNTY DEPARTMENT OF PLANNING AND ZONING.  11/15/99 DATE	
CHIEF, DEVELOPMENT ENGINEERING DIVISION 11/15/99 DATE	
CHIEF, DIVISION OF LAND DEVELOPMENT 11/15/99 DATE	
OWNER AUDREY OHENS ETAL 7533 GLENEAGLE DR. JESSUP, MD 20714 (410) 794-4655	OWNER ON HOSPITALITY MANAGEMENT, INC. 6251 WASHINGTON BLVD. ELKBRIDGE, MD 21075 (410) 314-3045
DEVELOPER ASTON PROPERTIES 6525 MORRISON BLVD., SUITE 300 CHARLOTTE, NC 28211 (704) 366-7337	
PROJECT CVS RETAIL STORE	
AREA Tax Map 37 Block 14, 20 Zoned B-1, B-2 6th Election District Howard County, Maryland	
TITLE SEDIMENT CONTROL NOTES AND DETAILS	
RIEMER MUEGGE & ASSOCIATES INC. ENGINEERING • ENVIRONMENTAL SERVICES • PLANNING • SURVEYING 8818 Centre Park Drive, Columbia, MD 21045 Tel 410.997.8800 Fax 410.997.9282	
DESIGNED BY : C.J.R. DRAWN BY : D.A.M. PROJECT NO : 98313 SDPS.DWG DATE : OCTOBER 13, 1999 SCALE : AS SHOWN DRAWING NO. 5 OF 8	


AS-BUILT 9/11/00 SDP-99-123



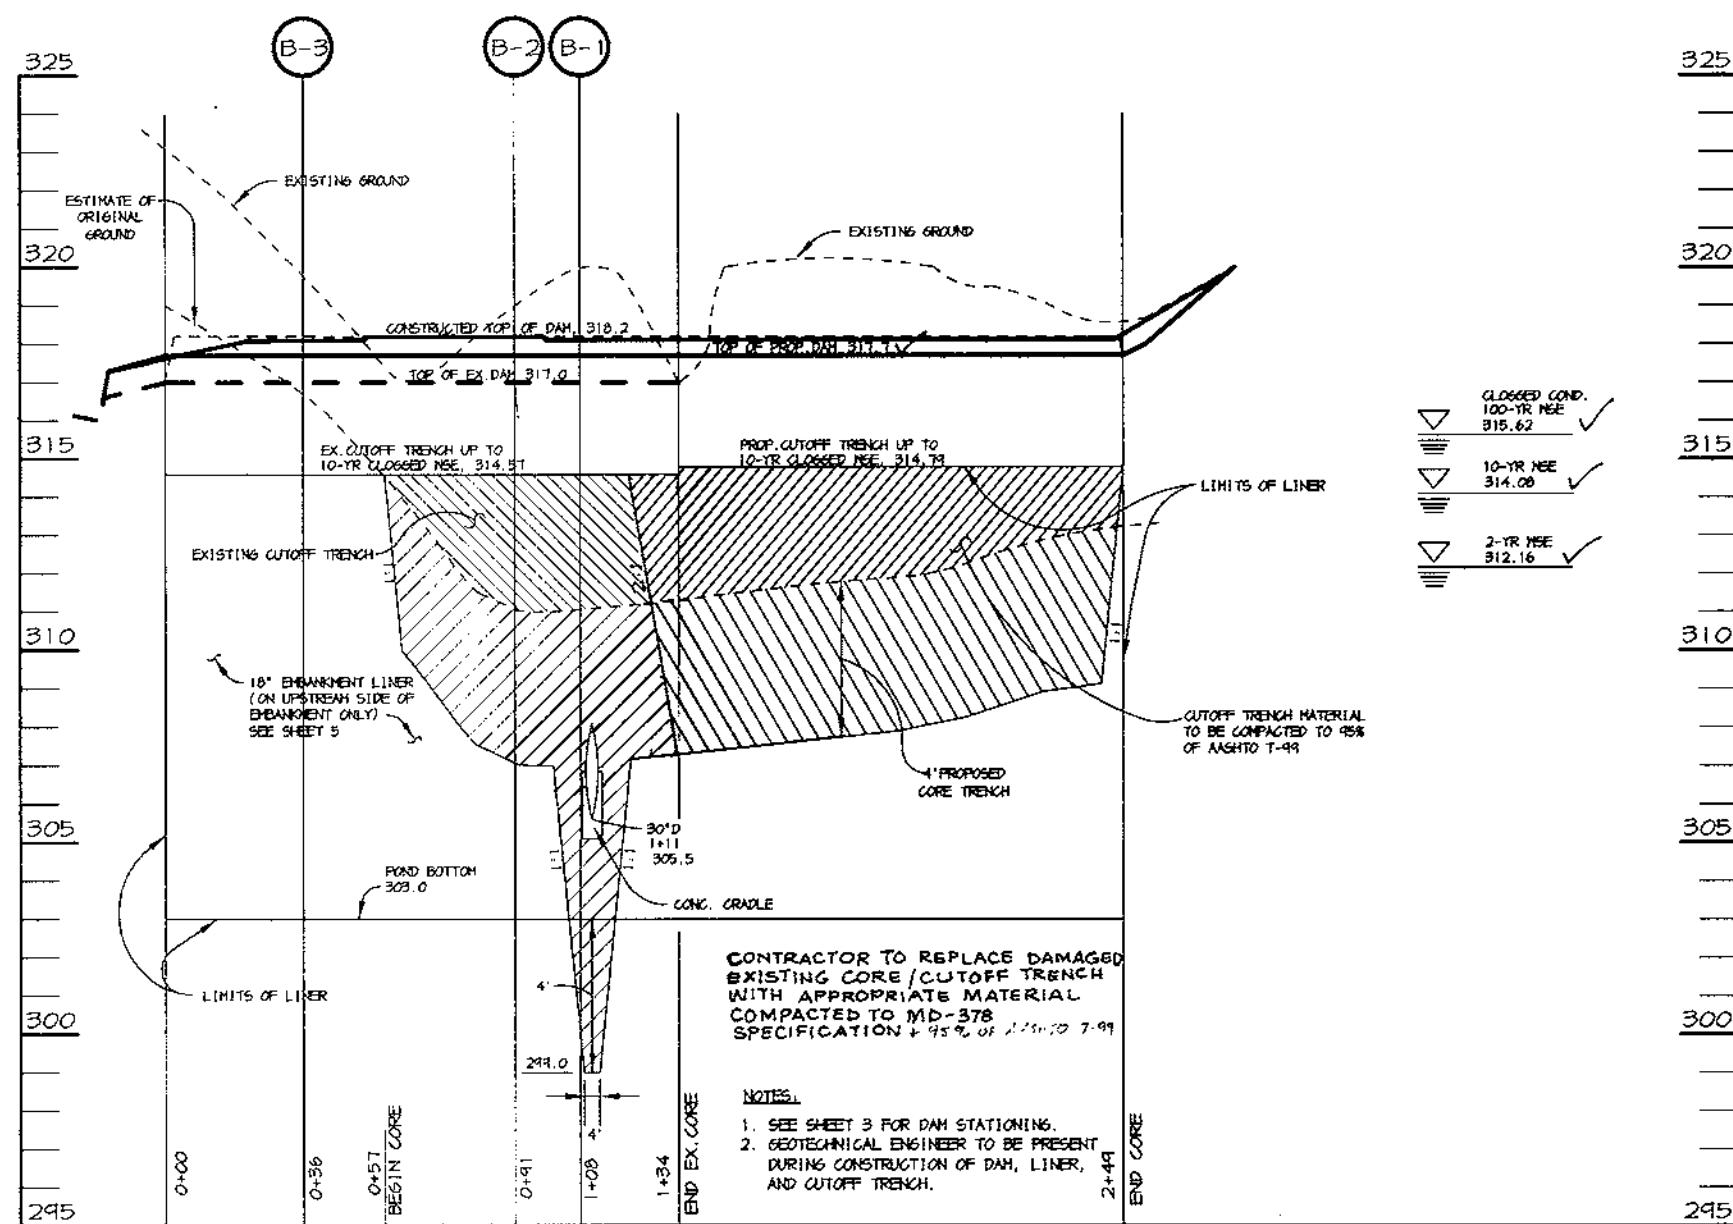


PROFILE OF EMBANKMENT &

SCALE  
HOR. - 1"=50'  
VERT. - 1"=5'

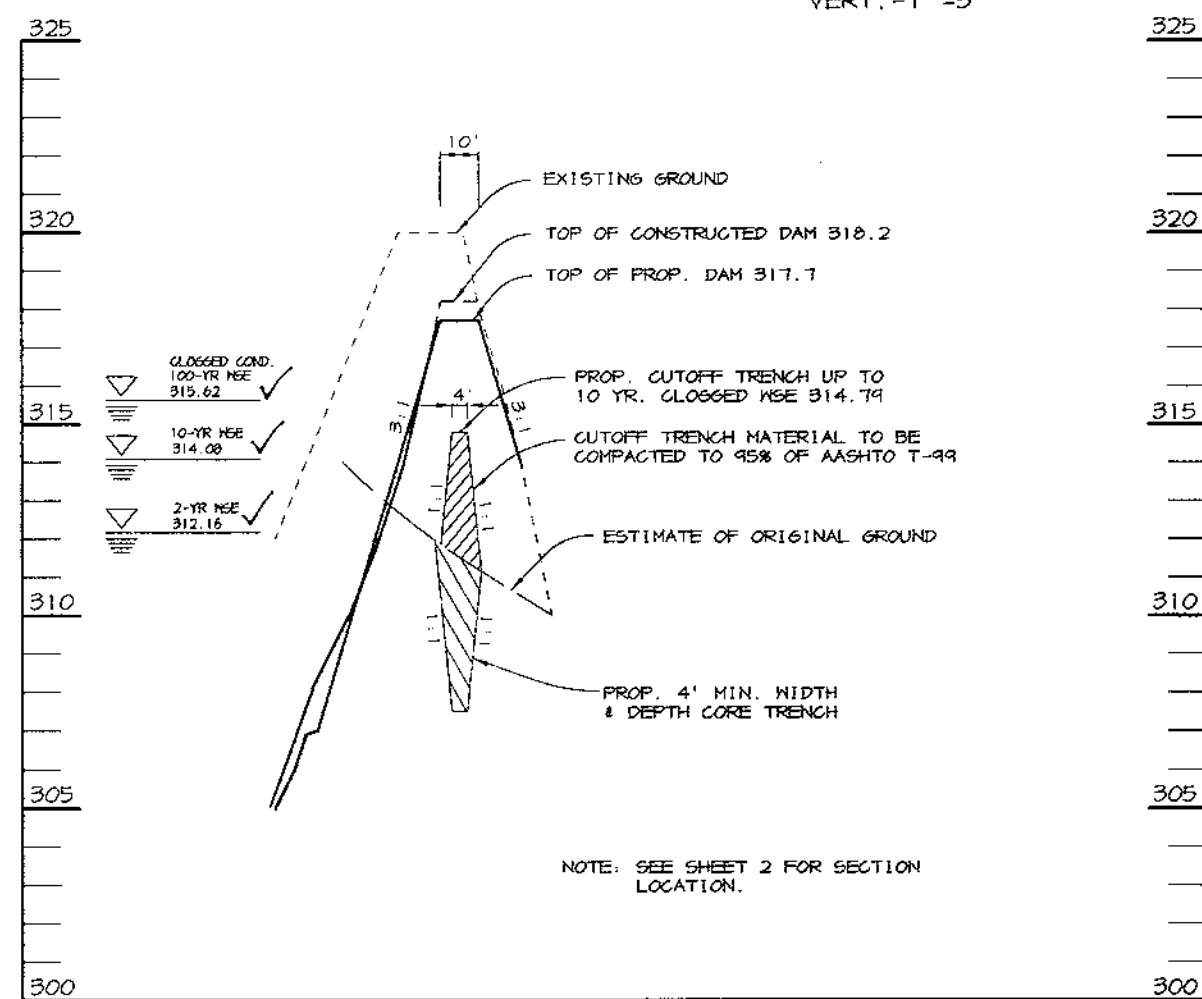


SECTION A-A THROUGH EMBANKMENT

SCALE  
HOR. - 1"=50'  
VERT. - 1"=5'

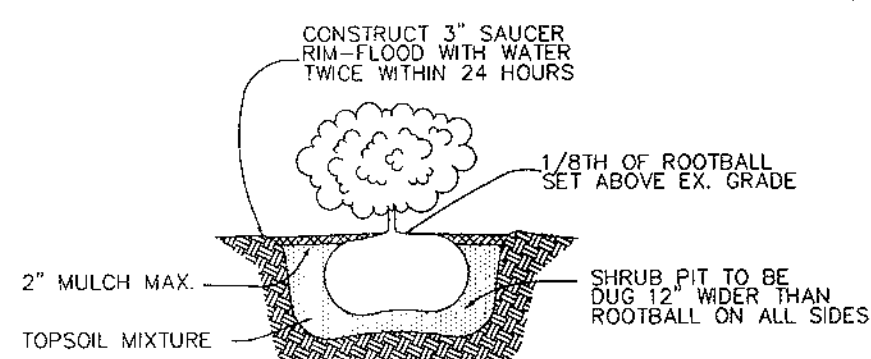

SHRUB PLANTING DETAIL

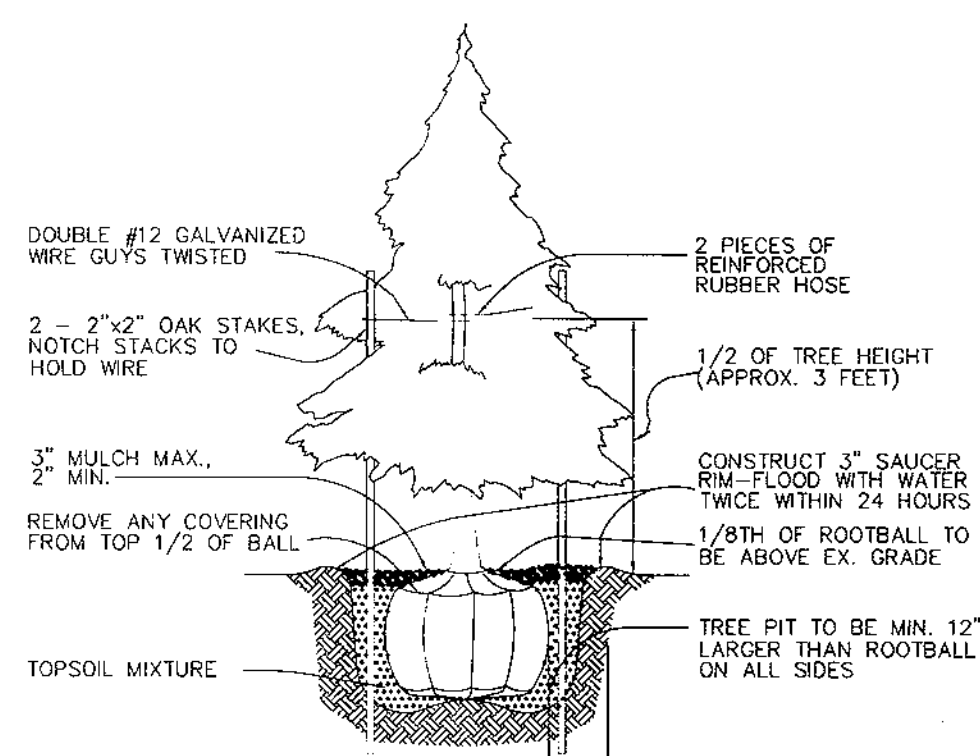

EVERGREEN PLANTING DETAIL

## PLANTING DETAILS

### GEOTECHNICAL RECOMMENDATIONS FOR POND CONSTRUCTION

- STRUCTURE S-4 FOUNDATION MATERIALS TO BE VISUALLY EXAMINED AND TESTED FOR A NET BEARING PRESSURE OF 2500 psf (MIN.) IMMEDIATELY PRIOR TO PLACEMENT OF FOUNDATION CONCRETE.
- PRIOR TO BACKFILLING, EXPOSED SUBGRADE SHALL BE EXAMINED, PROOFROLLED, AND/OR PROBED AS NECESSARY AND UNSTABLE MATERIALS SHALL BE REFILLED AND COMPACTED WITH APPROVED FILL.
- DENATURING DURING CONSTRUCTION SHALL BE ACCOMPLISHED USING INTERCEPTOR TRENCHES, SUMPS, AND/OR PUMPS AS NECESSARY TO TWO FEET BELOW THE BOTTOM OF THE CONSTRUCTION AREA. SUMPS SHALL BE REMOVED AND BACKFILLED WITH CLAYEY SOILS AFTER CONSTRUCTION. GRAVEL MAY BE USED TO PROVIDE A WORKING SURFACE, BUT NOT BENEATH THE FOOTPRINT OF THE EMBANKMENT.
- SURFACE RUNOFF SHALL BE DIVERTED AWAY FROM THE LIMITS OF CONSTRUCTION BY BERMING, TRENCHING, AND/OR GRADING AS NECESSARY. THE GROUND SURFACE SHALL BE SEALED WITH A SMOOTH DRUM ROLLER AT THE END OF EACH MORNING AND PRIOR TO RAINFALL. WATER SHALL NOT BE ALLOWED TO POND ON TOP OF SLOPE AREAS.
- A SHEEPFOOT ROLLER SHALL BE USED FOR COMPACTION; A SMOOTH DRUM ROLLER SHALL BE USED FOR SEALING ONLY.
- A SOIL TECHNICIAN SHALL BE PRESENT DURING FILL OPERATIONS TO OBSERVE AND TEST COMPACTION. DENSITY TESTS SHALL BE 1" TEST PER 2500 sq ft OF FILL AREA (MIN.) FOR EACH LIFT PLACED.

### OPERATION, MAINTENANCE AND INSPECTION

INSPECTION OF THE POND SHOWN HEREON SHALL BE PERFORMED AT LEAST ONCE ANNUALLY, IN ACCORDANCE WITH THE CHECKLIST AND REQUIREMENTS CONTAINED WITHIN USDA, SCS "STANDARDS AND SPECIFICATION FOR PONDS" (MD318). THE POND OWNER AND ANY HEIRS, SUCCESSORS, OR ASSIGNS SHALL BE RESPONSIBLE FOR THE SAFETY OF THE POND AND THE CONTINUED OPERATION, SURVEILLANCE, INSPECTION, AND MAINTENANCE THEREOF. THE POND OWNER SHALL PROMPTLY NOTIFY THE SOIL CONSERVATION DISTRICT OF ANY UNUSUAL OBSERVATIONS THAT MAY BE INDICATIONS OF DISTRESS SUCH AS EXCESSIVE SEEPAGE, TURBID SEEPAGE, SLIDING OR SLUMPING.

#### OPERATION AND MAINTENANCE SCHEDULE FOR BAYSAYER WATER QUALITY DEVICE

- Stormceptor water quality structures will require periodic inspection and cleaning to maintain operation and function. Owners will have the Stormceptor unit inspected yearly or as required by Howard County, utilizing the Stormceptor Inspection/Monitoring Form. Inspections can be done by using a clear Plexiglas tube ("sludge judge") to extract a water column sample. When sediment depths exceed the specified level (Table 6 of Technical Manual) then cleaning of the unit is required.
- Stormceptor water quality structures must be checked and cleaned immediately after petroleum spills. Contact appropriate regulatory agencies.
- Maintenance of Stormceptor units should be done by a vacuum truck which will remove the water, sediment, debris, floating hydrocarbons, and other materials in the unit. The proper cleaning and disposal of the removed materials and liquid must be followed.
- Inlet and outlet pipes must be checked for any obstructions and if any obstructions are found they must be removed. Structural parts of the Stormceptor will be repaired as needed.
- Owner shall retain and make Stormceptor Inspection/Monitoring Forms available to Howard County officials upon their request.


#### OPERATION AND MAINTENANCE SCHEDULE OF PRIVATELY OWNED AND MAINTAINED STORMWATER MANAGEMENT FACILITY RETENTION POND

##### ROUTINE MAINTENANCE

- Facility shall be inspected annually and after major storms. Inspections should be performed during wet weather to determine if the pond is functioning properly.
- Top and side slopes of the embankment shall be mowed a minimum of two (2) times a year, once in June and once in September. Other side slopes and maintenance access should be mowed as needed.
- Debris and litter next to the outlet structure shall be removed during regular mowing operations and as needed.
- Visible signs of erosion in the pond as well as riprap outlet area shall be repaired as soon as it is noticed.

##### NON-ROUTINE MAINTENANCE

- Structural components of the pond such as the dam, the riser, and the pipes shall be repaired upon the detection of any damage. The components should be inspected during routine maintenance operations.
- Sediment should be removed when its accumulation significantly reduces the design storage, interferes with the function of the riser, when deemed necessary for aesthetic reasons, or when deemed necessary by the Howard County's Department of Public Works.

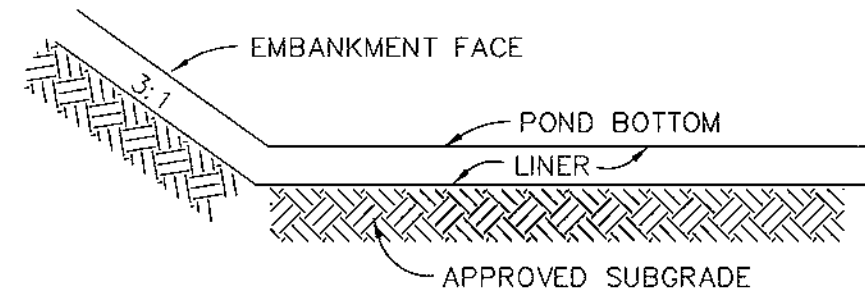


##### LINER NOTES:

- THE LINER SHALL BE AT LEAST 18" THICK PLACED AS COMPACTED FILL IN LOOSE LIFTS OF 8", COMPACTED TO 95% OF THE MAXIMUM DRY DENSITY AS DETERMINED BY THE STANDARD PROCTOR METHOD (ASTM D-698).
- FILL MATERIAL FOR THE LINER SHALL CONSIST OF SILTY OR SANDY CLAY (CL), OR CLAYEY SAND (SC). CLAYEY SAND MATERIALS SHALL HAVE NO LESS THAN 30% PASSING THE No. 200 SIEVE. OTHER BACKFILL MATERIALS MAY BE CONSIDERED AND APPROVED BY THE GEOTECHNICAL ENGINEER.
- THE LINER SUBGRADE SHALL BE OBSERVED BY THE GEOTECHNICAL ENGINEER TO BE STABLE PRIOR TO BACKFILLING THE LINER.
- THE LINER SHALL EXTEND VERTICALLY AT LEAST TO THE 10-YEAR WATER SURFACE ELEVATION.

##### LINER DETAIL

NO SCALE

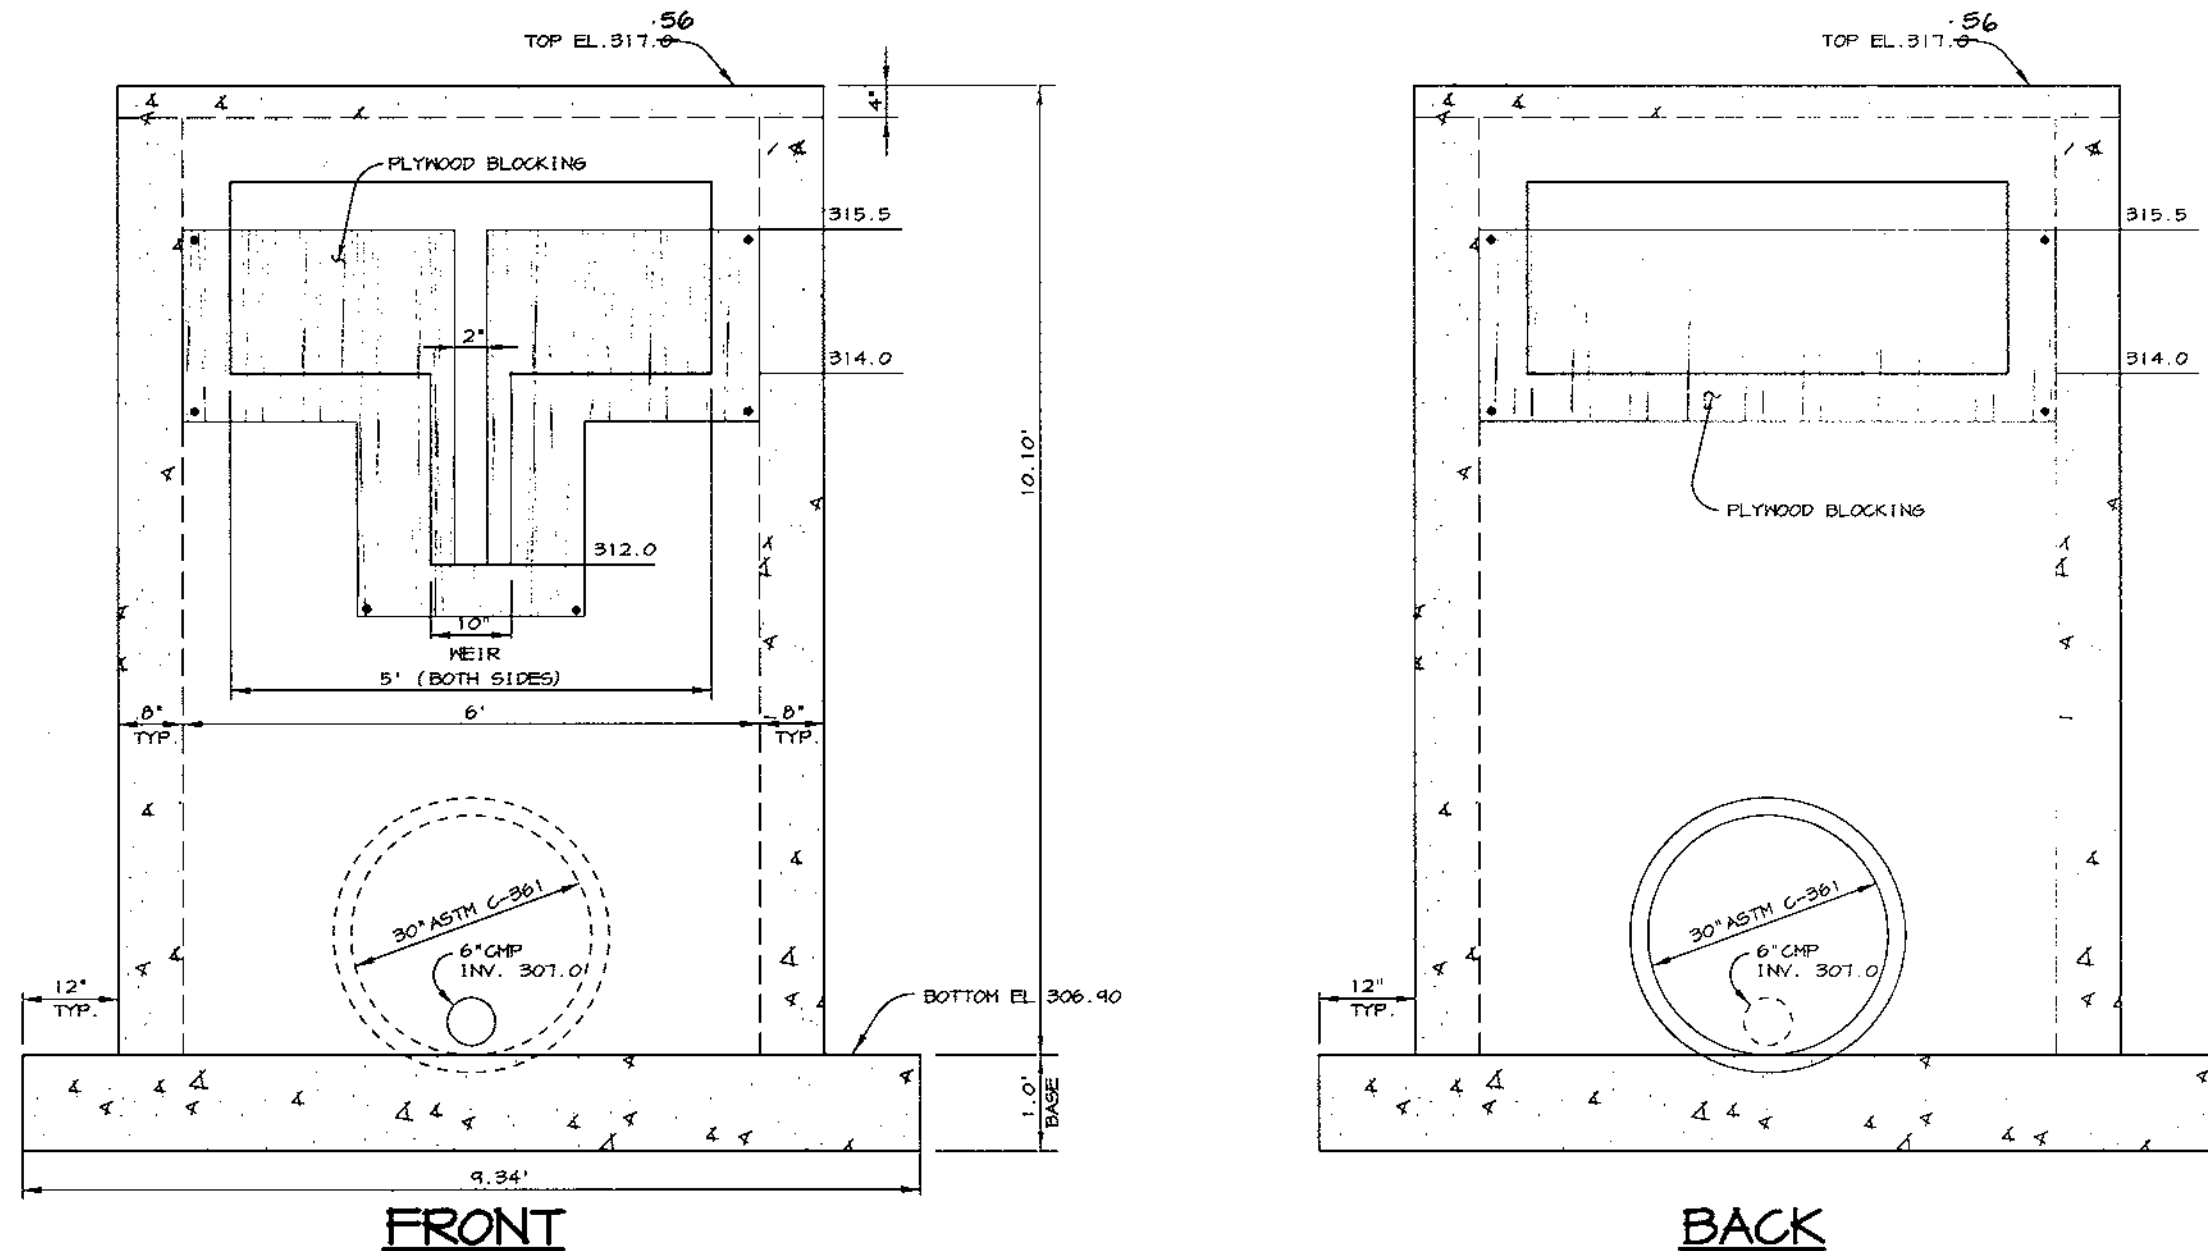

### EXISTING S-4 DETAIL

SCALE: 1"=2'

- NOTES: 1. OTHER THAN THE MODIFICATIONS SHOWN HERE, THIS STRUCTURE SHALL BE CONSTRUCTED IN ACCORDANCE WITH HO. CO. STD. DETAIL SD 4.01, HOWEVER A BRICK STRUCTURE IS NOT ALLOWED.
- SHOP DRAWINGS TO BE SUBMITTED TO HOWARD COUNTY AND CONSULTANT PRIOR TO FABRICATION.
  - DURING CONSTRUCTION, OPENING TO BE BLOCKED USING PLYWOOD BOLTED TO INSIDE OF RISER UP TO ELEV. 315.5. ALL SEALS TO BE WATER TIGHT. A 3" MIER STARTING AT 312.0 TO BE CUT INTO PLYWOOD.
  - REMOVE EXISTING TRASH RACK IF NECESSARY TO ATTACH PLYWOOD AND REPLACE AFTER PLYWOOD IS IN PLACE.

NOTE: CONTRACTOR TO REGRADE, SOD OR HYDROSEED AND STRAW MULCH ALL AREAS DISTURBED AS A RESULT OF THEIR WORK.

SPRAY WITH WILT-PROOF ACCORDING TO MANUFACTURER'S STANDARD

PRUNE ONLY TO CORRECT OR IMPROVE FORM OR TO REMOVE DEAD, CONFLICTING OR DAMAGED BRANCHES.

2 PIECES OF REINFORCED RUBBER HOSE

DOUBLE #12 GALVANIZED WIRE GUYS TWISTED

3 - 2" x 2" OAK STAKES, NOTCH STACKS TO HOLD WIRE

BLACK CORRUGATED PLASTIC PIPE


REMOVE 1/2 OF ANY COVERING FROM TOP OF ROOT CROWN

3" MULCH MAX., 2" MIN.


CONSTRUCT 3" SAUCER RIM-FLOOD WITH WATER TWICE WITHIN 24 HOURS

TOP SOIL MIXTURE


CONVEX BOTTOM 6" MIN. HT.

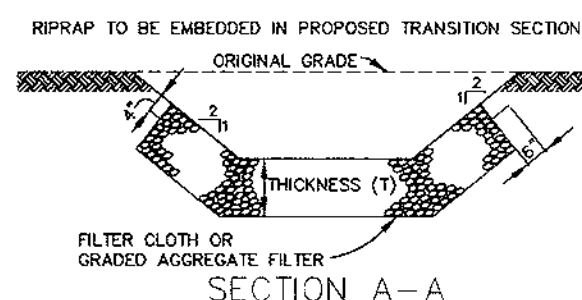

SECTION A-A

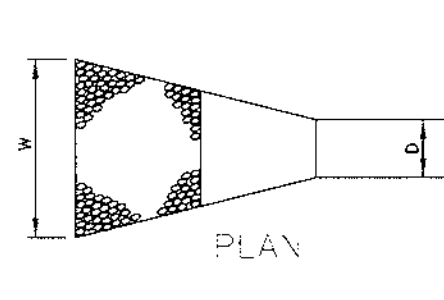

PLAN

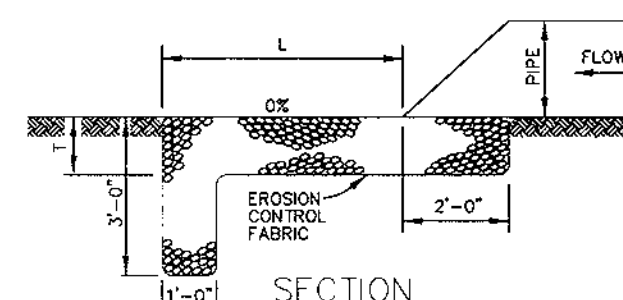


SECTION

STRUCTURE	MEDIAN STONE DIA. (I)	LENGTH (L)	WIDTH (W)	THICKNESS (T)	Q <sub>u</sub>	V	DEPTH	SPA CLASS
E-1	9.5"	49'	10'	19"	10.00 cfs	6.1 fph	0.49'	I

### RIPRAP OUTLET PROTECTION DETAIL


NO SCALE

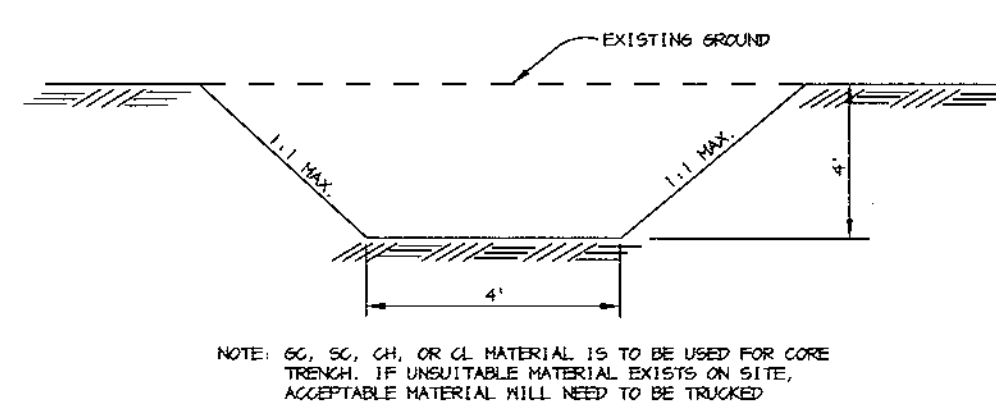


### CORE TRENCH DETAIL

NO SCALE


		<b>CERTIFICATE</b> CHRISTOPHER J. REID #19949 DATE 9-12-00	
BY THE DEVELOPER: I/WE CERTIFY THAT ALL DEVELOPMENT AND/OR CONSTRUCTION WILL BE DONE ACCORDING TO THESE PLANS, AND THAT ANY RESPONSIBLE PERSONNEL INVOLVED IN THE CONSTRUCTION PROJECT WILL HAVE A CERTIFICATE OF ATTENDANCE AT A DEPARTMENT OF THE ENVIRONMENT APPROVED TRAINING PROGRAM FOR THE CONTROL OF SEDIMENT AND EROSION BEFORE BEGINNING THE PROJECT. I SHALL ENGAGE A REGISTERED PROFESSIONAL ENGINEER TO SUPERVISE POND CONSTRUCTION AND PROVIDE THE HOWARD SOIL CONSERVATION DISTRICT WITH AN "AS-BUILT" PLAN OF THE POND WITHIN 30 DAYS OF COMPLETION. I ALSO AUTHORIZE PERIODIC ON-SITE INSPECTIONS BY THE HOWARD SOIL CONSERVATION DISTRICT.			
DEVELOPER 		DATE 10-7-99	
BY THE ENGINEER: I CERTIFY THAT THIS PLAN FOR POND CONSTRUCTION, EROSION AND SEDIMENT CONTROL REPRESENTS A PRACTICAL AND WORKABLE PLAN BASED ON MY PERSONAL KNOWLEDGE OF THE SITE CONDITIONS AND PREPARED IN ACCORDANCE WITH THE REQUIREMENTS OF THE HOWARD SOIL CONSERVATION DISTRICT. I HAVE NOTIFIED THE DEVELOPER THAT HE/SHE MUST ENGAGE A REGISTERED PROFESSIONAL ENGINEER TO SUPERVISE POND CONSTRUCTION AND PROVIDE THE HOWARD SOIL CONSERVATION DISTRICT WITH AN "AS-BUILT" PLAN OF THE POND WITHIN 30 DAYS OF COMPLETION.			
ENGINEER 		DATE 8-6-99	
THESE PLANS HAVE BEEN REVIEWED FOR THE HOWARD SOIL CONSERVATION DISTRICT AND MEET THE TECHNICAL REQUIREMENTS FOR SMALL POND CONSTRUCTION, SOIL EROSION AND SEDIMENT CONTROL.			
NATURAL RESOURCES CONSERVATION SERVICE 		DATE 11/2/99	
THESE PLANS FOR SMALL POND CONSTRUCTION, SOIL EROSION AND SEDIMENT CONTROL MEET THE REQUIREMENTS OF THE HOWARD SOIL CONSERVATION DISTRICT.			
HOWARD SOIL CONSERVATION DISTRICT 		DATE 11/2/99	
APPROVED: FOR PUBLIC WATER AND PUBLIC SEWERAGE SYSTEMS, HOWARD COUNTY HEALTH DEPARTMENT. JUNE MATHIAS M.D. / JESSEUP, MD 20144 COUNTY HEALTH OFFICER: HR			
APPROVED: HOWARD COUNTY DEPARTMENT OF PLANNING AND ZONING. JEN S. SMITH / DIRECTOR CHIEF, DEVELOPMENT ENGINEERING DIVISION CAROL HANNAH / CHIEF, DIVISION OF LAND DEVELOPMENT			
DATE NO. REVISION			
OWNER AUDREY OWENS ETAL 7533 GLENLEAGUE DR. JESSEUP, MD 20144 (410) 799-4655		OWNER OM HOSPITALITY MANAGEMENT, INC. 6251 WASHINGTON BLVD. ELKRIE, MD 21075 (410) 374-3045	
DEVELOPER ASTON PROPERTIES 6525 MORRISON BLVD., SUITE 300 CHARLOTTE, NC 28211 (704) 366-7337			
PROJECT CVS RETAIL STORE			
AREA Parcels 259 & 260 Tax Map 37 Block 14, 20 Zoned B-1, B-2 6th Election District Howard County, Maryland			
TITLE SWM PROFILES AND DETAILS			
RIEMER MUEGGE & ASSOCIATES INC. ENGINEERING • ENVIRONMENTAL SERVICES • PLANNING • SURVEYING 8818 Centre Park Drive, Columbia, MD 21045 tel 410.997.8900 fax 410.997.9282			
DATE DESIGNED BY: C.J.R. DRAWN BY: D.A.M. PROJECT NO: 98313 DATE: OCTOBER 13, 1999 SCALE: AS SHOWN DRAWING NO. 6 OF 8		PROFESSIONAL ENGINEER ARTHUR E. MUEGGE #8707	

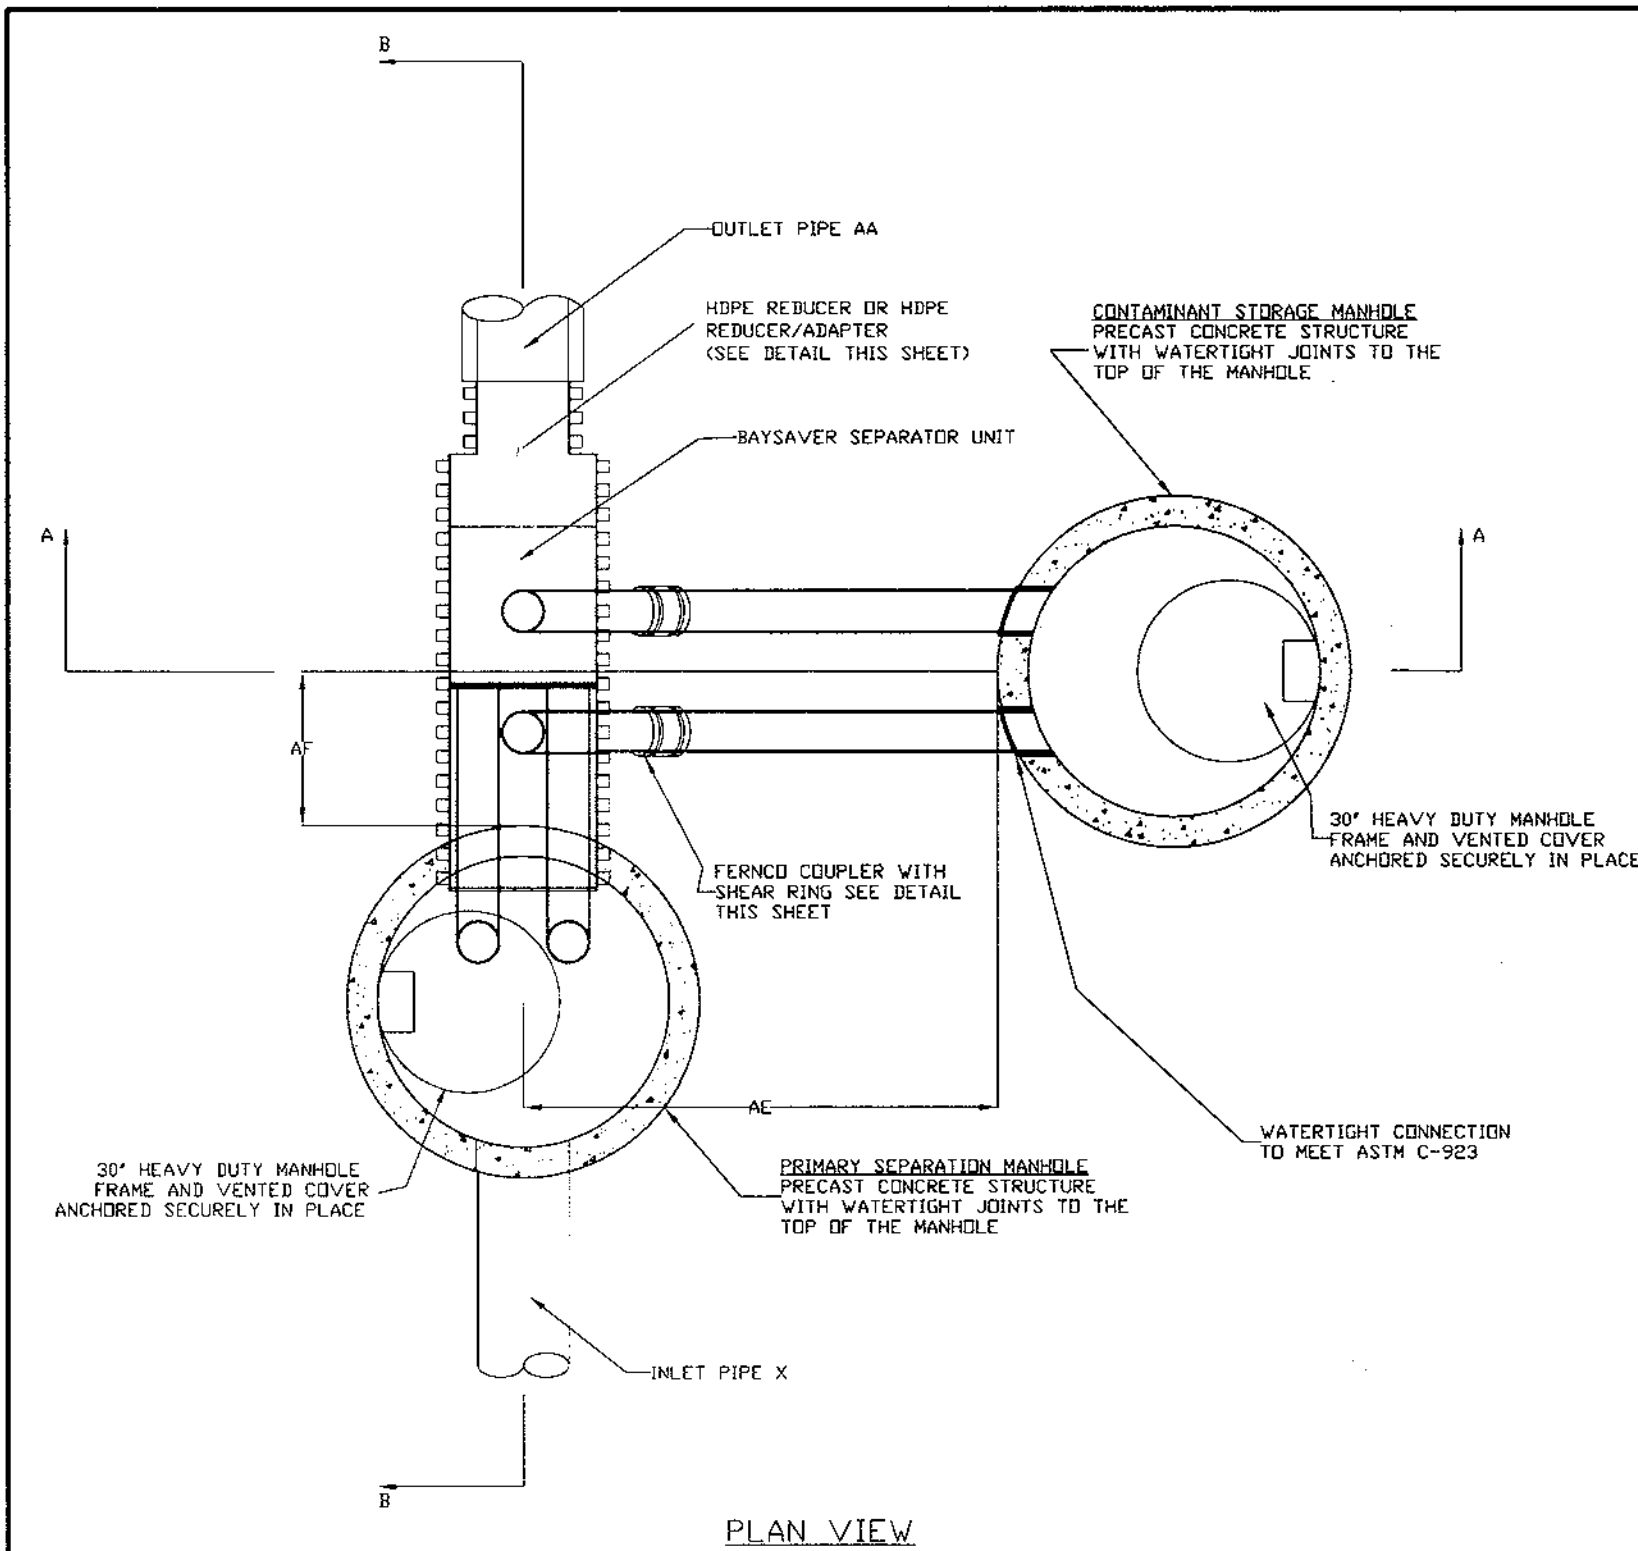



PLAN VIEW

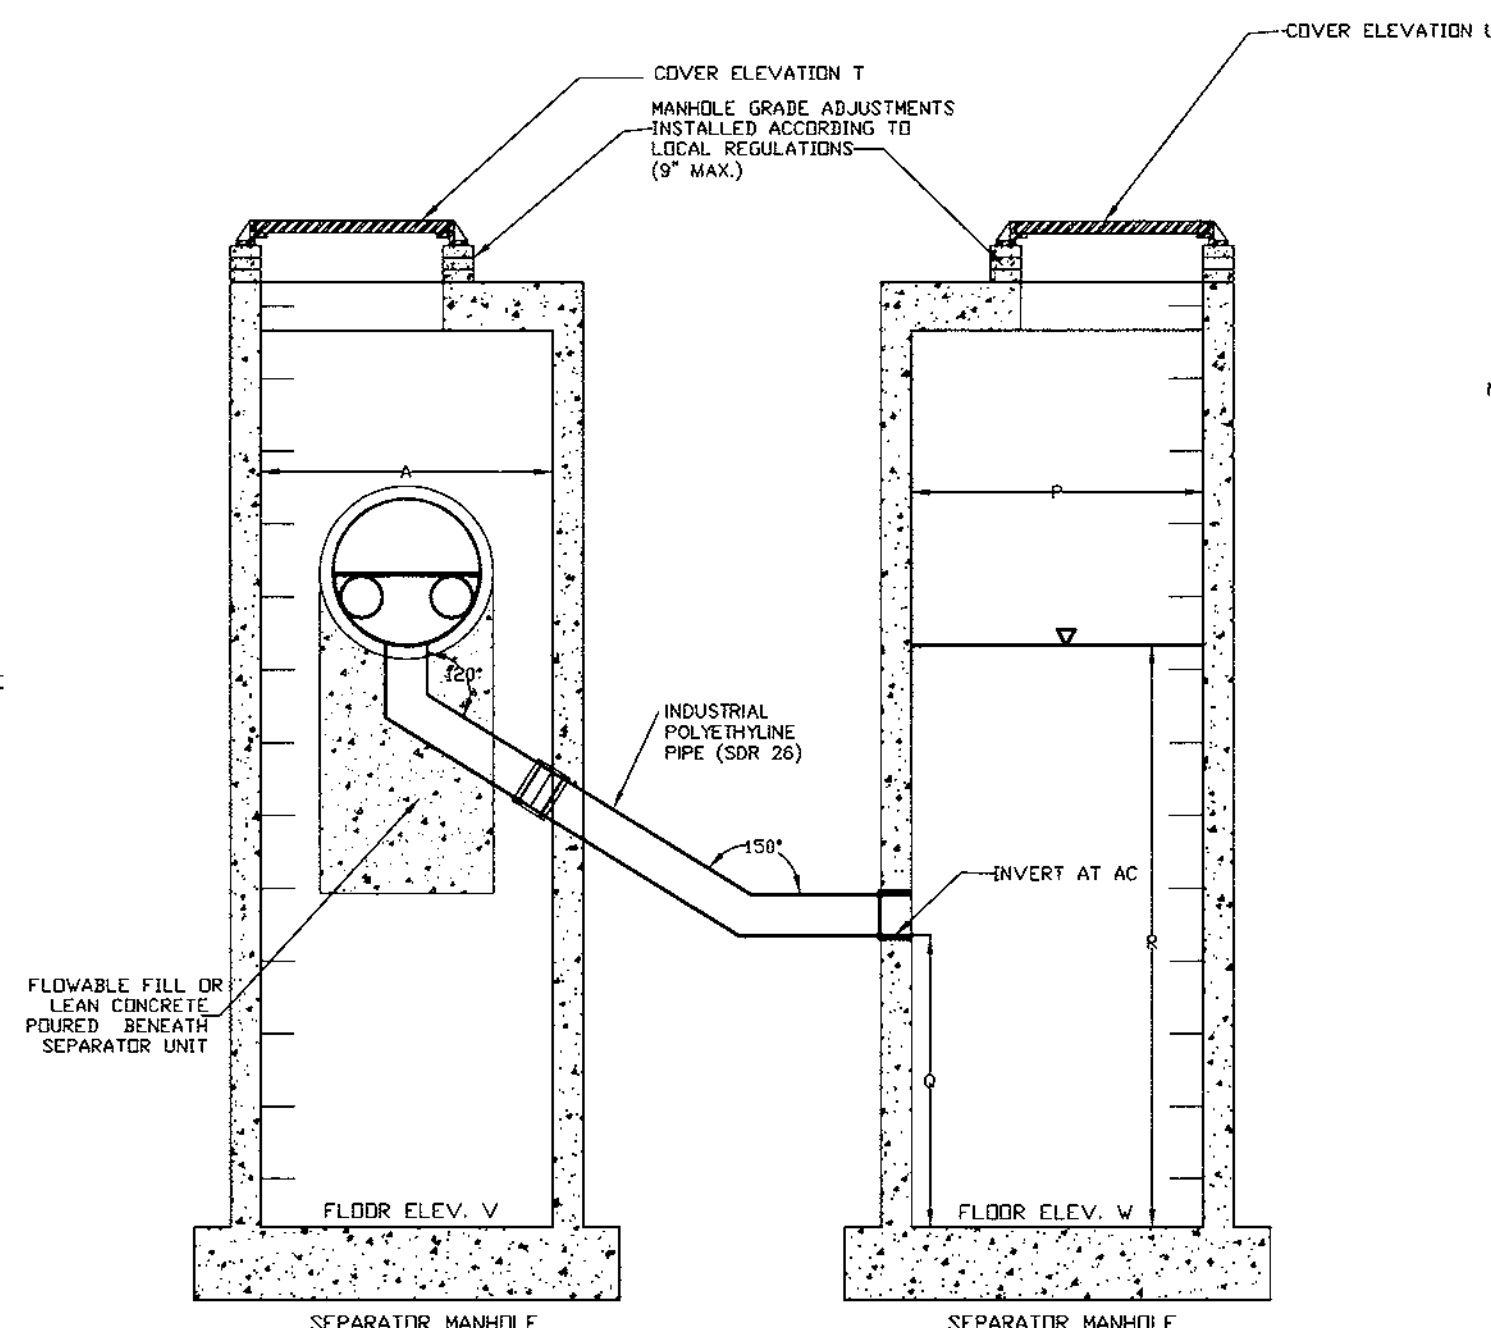

SECTION AA

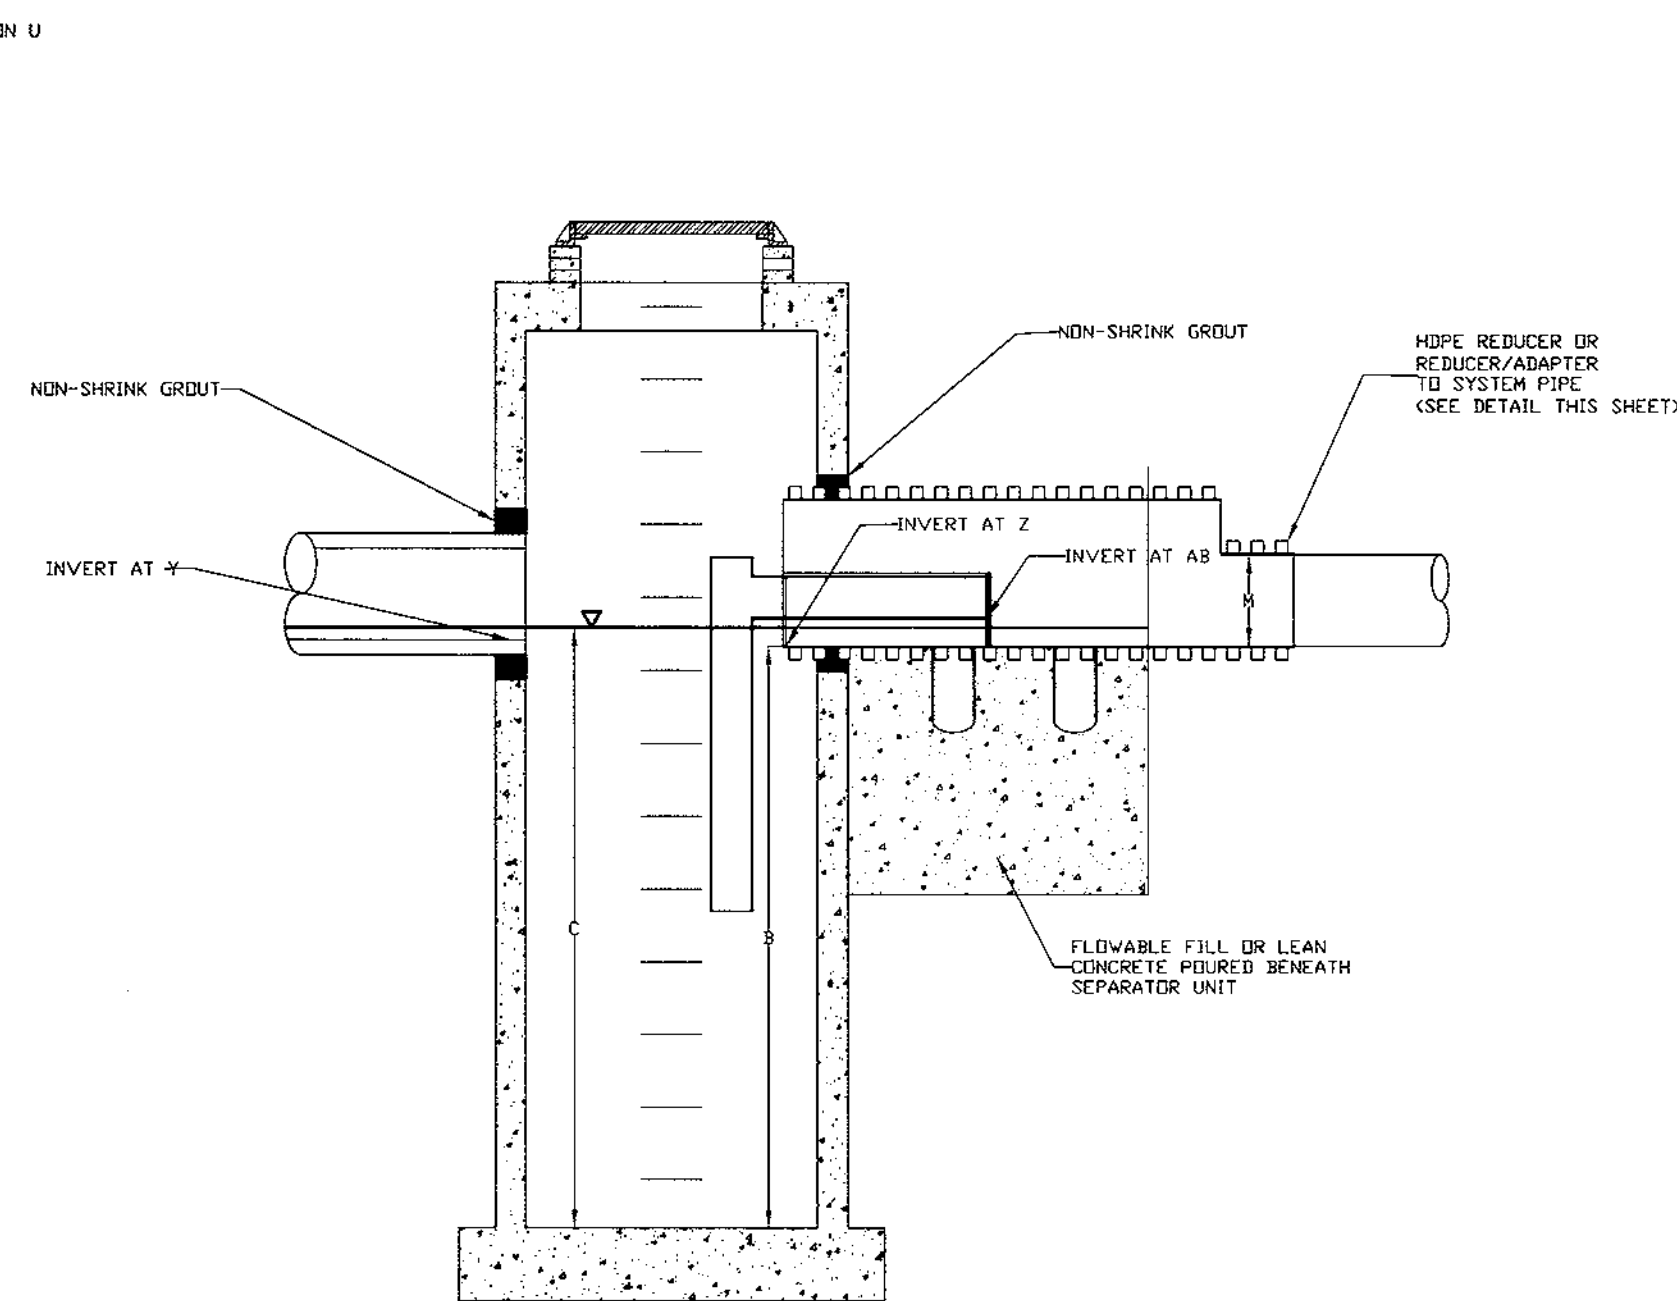


SECTION BB

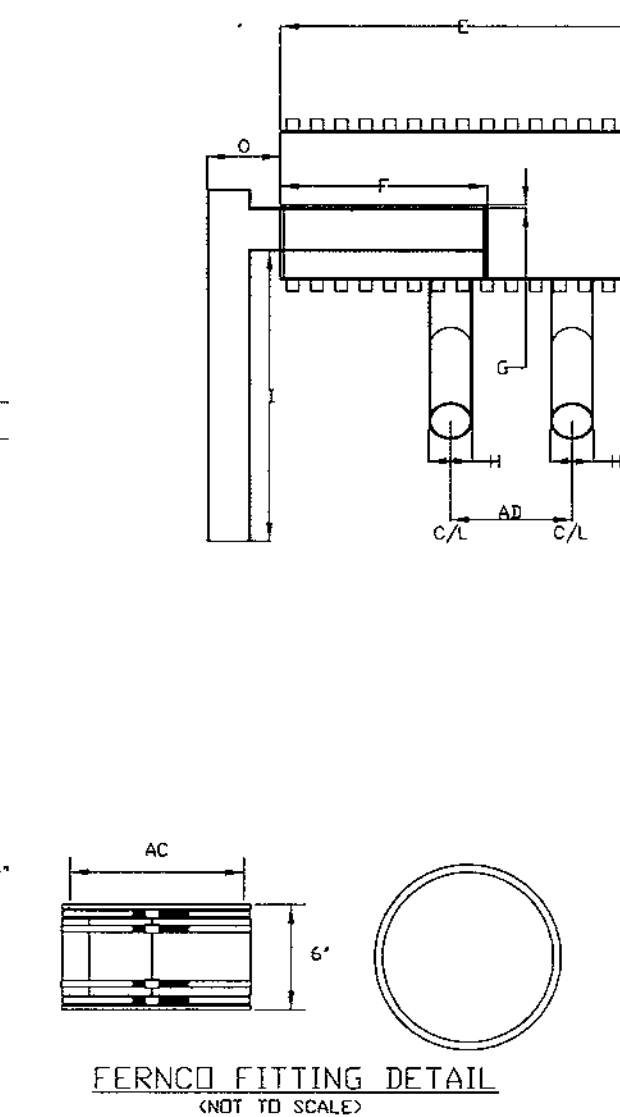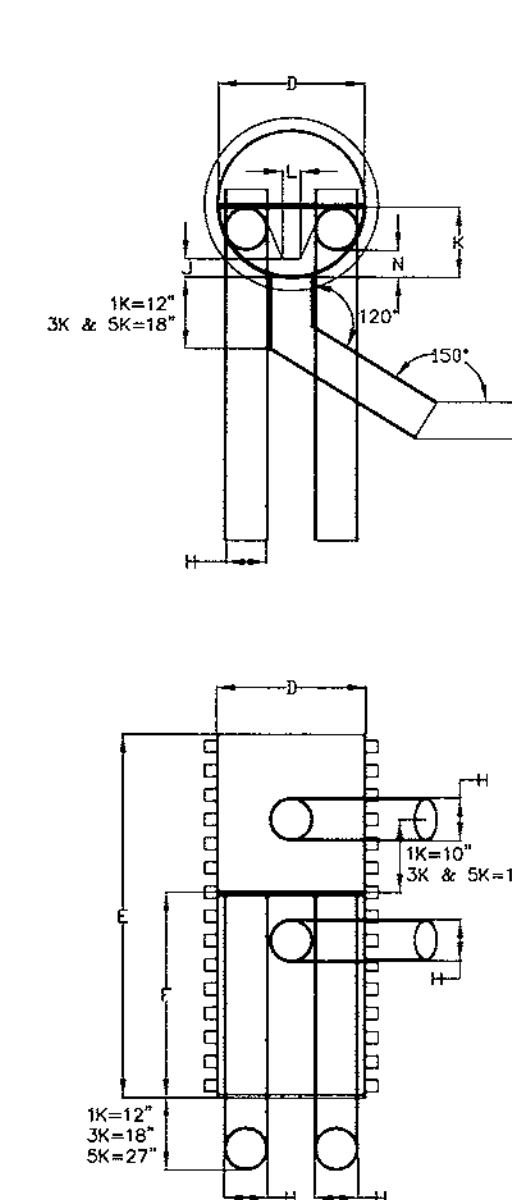


DISTANCE AC	FERNCO NO.	SHEAR RING
1K	7.10"	1055-66
3K	10.60"	1056-1010
5K	12.73"	1064-1010

### HDPE-HDPE REDUCER DETAIL

FOR USE WITH HDPE OUTLET PIPES  
NOT TO SCALE

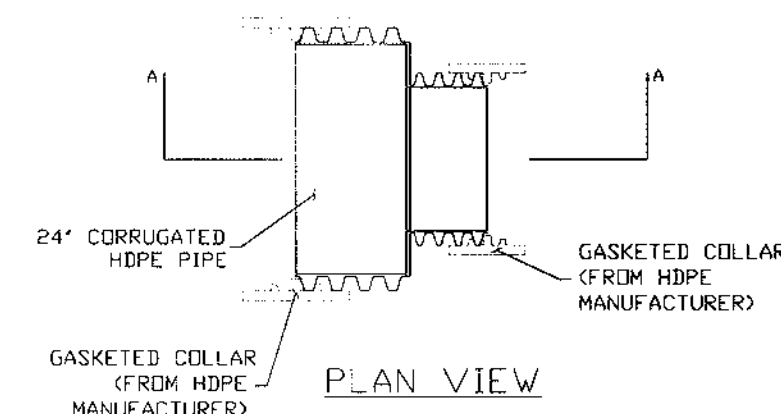


PLAN VIEW

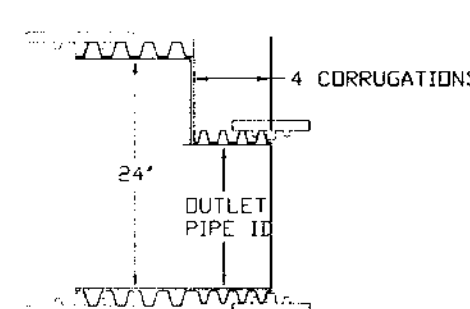


SECTION AA

### REDUCER/ADAPTER DETAIL

FOR USE WITH OUTLET PIPES OTHER THAN HDPE  
NOT TO SCALE

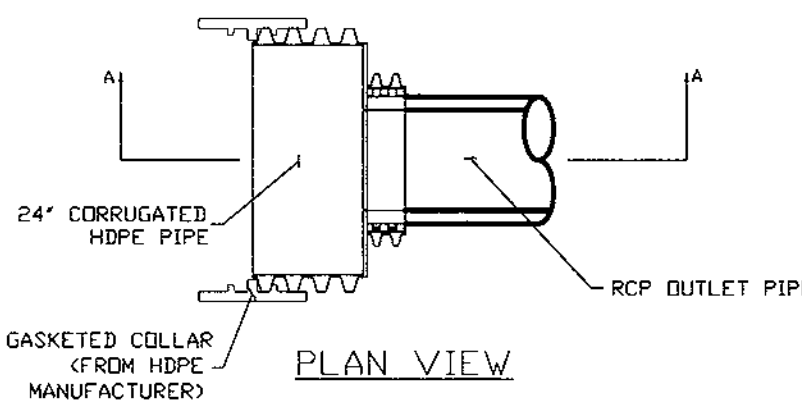

PLAN VIEW

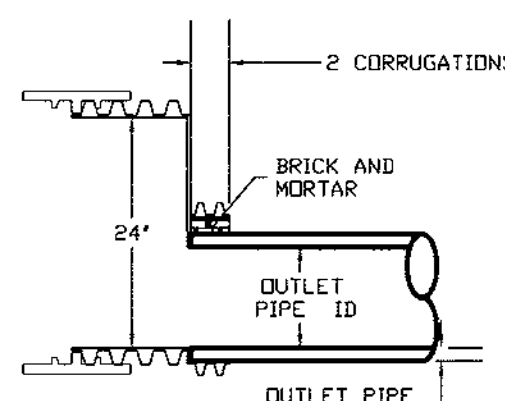

SECTION AA

### GENERAL CONSTRUCTION NOTES

1. ALL WORK MUST BE DONE WITH REGARD FOR THE SAFETY OF THE CONSTRUCTION CREW.
2. ALL WORK AND MATERIALS MUST COMPLY WITH APPLICABLE STATE AND LOCAL REGULATIONS.
3. KNOW THE LOCATION AND DEPTH OF ANY UNDERGROUND UTILITIES BEFORE EXCAVATION BEGINS.

### BAYSAYER MAINTENANCE

BAYSAYER SYSTEMS MUST BE INSPECTED AND MAINTAINED PERIODICALLY. INSPECTION IS MADE BY CHECKING THE DEPTH OF SEDIMENT IN EACH MANHOLE WITH A GRADE STICK OR SIMILAR DEVICE. MAINTENANCE IS REQUIRED WHEN THE SEDIMENT DEPTH IN EITHER MANHOLE EXCEEDS 2 FEET. MINIMUM INSPECTION IS REQUIRED TWICE A YEAR TO MAINTAIN OPERATION AND FUNCTION OF BAYSAYER.

MAINTENANCE CONSISTS OF THE FOLLOWING:

#### A. CONTAMINANT STORAGE MANHOLE

1. REMOVE THE ENTIRE VOLUME OF THE CONTAMINATED WATER BY VACUUM TRUCK.
2. CLEAN THE MANHOLE WALLS AND FLUSH OUT THE MANHOLE USING A HIGH PRESSURE HOSE AND REMOVE FLUSHING WATER BY VACUUM TRUCK. MAKE CERTAIN MANHOLE IS CLEAN.

#### B. PRIMARY SEPARATION MANHOLE

1. USING A SUBMERSIBLE PUMP, PUMP THE CLEAN WATER FROM THE CENTER OF THE MANHOLE DIRECTLY INTO THE EMPTY STORAGE MANHOLE UNTIL THE WATER LEVEL FALLS TO 1 FOOT ABOVE THE SEDIMENT LAYER.
2. REMOVE THE SETTLED SEDIMENT AND REMAINING WATER BY VACUUM TRUCK.
3. CLEAN THE MANHOLE WALLS AND FLUSH OUT THE MANHOLE USING A HIGH PRESSURE HOSE AND REMOVE FLUSHING WATER BY VACUUM TRUCK. MAKE CERTAIN MANHOLE IS CLEAN.
4. CONTAMINATED MATERIAL REMOVED FROM THE MANHOLES MUST BE DISPOSED OF RESPONSIBLY AND LEGALLY BY THE OPERATOR OF THE VACUUM TRUCK.

### BAYSAYER INSTALLATION INSTRUCTIONS

1. EXCAVATION MUST PROVIDE ADEQUATE SPACE TO CONNECT INLET AND OUTLET PIPES TO SEPARATOR MANHOLE AND BAYSAYER UNIT. INSTALL PRECAST DROP STRUCTURES ON SOLID GROUND AS VERIFIED BY A GEOTECHNICAL ENGINEER.
2. VERIFY THE SUBGRADE ELEVATION AGAINST THE MANHOLE DIMENSIONS AND CONNECTING STORM DRAIN INVERTS.
3. MAKING SURE THE BASES ARE LEVEL AND THE STORAGE MANHOLE OPENINGS ARE ALIGNED WITH THE SEPARATOR UNIT, INSTALL PRIMARY AND STORAGE MANHOLES. INSTALL RUBBER GASKETS ON BASE UNITS AND COAT WITH LUBRICATING GREASE. INSTALL ADDITIONAL MANHOLE SECTIONS AS REQUIRED. SEAL LIFT HOLES WITH NON-SHRINK GROUT.
4. BACKFILL BASE SECTIONS OF MANHOLES TO INVERT OF STORAGE MANHOLE CONNECTING PIPES. USING APPROVED BACKFILL MATERIAL, BACKFILL AND COMPACT IN 8 INCH LIFTS. BACKFILL AND COMPACTION SHOULD BE MONITORED BY A GEOTECHNICAL ENGINEER.
5. INSTALL BAYSAYER SEPARATOR UNIT AND CONNECTING PIPES. SEAL ALL CONNECTING JOINTS AND INSTALL SEPARATOR UNIT/STORM DRAIN JOINT COLLAR. CUT EXCESS LENGTH OFF CONNECTING PIPES INSIDE STORAGE MANHOLE.
6. BACKFILL SEPARATOR UNIT AND MANHOLES. AREAS NOT ACCESSIBLE TO COMPACTION EQUIPMENT MUST BE BACKFILLED WITH LEAN CONCRETE OR FLOWABLE FILL.
7. INSTALL AND SET MANHOLE COVER GRADE ADJUSTMENT RINGS AS NECESSARY.
8. INSTALL AND SET MANHOLE FRAME AND COVER UNITS.

### SEQUENCE OF CONSTRUCTION AND INSPECTOR'S CHECK-OFF LIST FOR DUAL MANHOLE SEPARATORS

Stage (X = Approval Required)	Developer's/Engineer Approval		Inspector		Geotechnical Engineer	
	Initials	Date	Initials	Date	Initials	Date
1. Pre-Construction Meeting.	X		X		X	
2. Install Manholes and associated storm drainage.						
a. Obtain approval of subgrade from Geotechnical Engineer. (Subgrade to have a minimum of 95% compaction)					X	
b. Installation of precast base, lower tank and lower piping.	X		X			
c. Backfill and min. 95% compaction around lower tank and lower piping.					X	
d. Installation of precast middle section(s) with separator unit and remaining piping.	X		X			
e. Installation of precast top slab.	X		X			
f. Installation of adjustment rings and frame and cover.	X		X			
g. Installation of flowable fill or concrete backfill.					X	
3. Backfilling operation and compaction.					X	
4. Site is permanently stabilized. Sediment control measures removed and all sediment and debris removed from dual manhole separators.			X			
5. Final inspection.			X			

### NOTE:

BAYSAYERS ARE TO BE INSTALLED WITH THE STORM DRAIN SYSTEM AND WILL FUNCTION AS SECONDARY SEDIMENT CONTROL DEVICES. UPON COMPLETION OF SITE STABILIZATION, EACH BAYSAYER SYSTEM SHALL BE FLUSHED CLEAN & THE MANHOLES CLEANED OUT AND REFILLED WITH CLEAN WATER.

NOTE: DIMENSIONAL SHOP DRAWINGS ARE TO BE APPROVED BY THE DESIGN ENGINEER

Baysaver Separator Unit	Baysaver Manhole Sizes (prim. x stor.)	Maximum Treatment (cfs)*1	Maximum Treatment (gpm)*1	Impervious Area (acres)
1K Baysaver Separator	48x48	2.4	1076	1.2
	48x50	2.4	1076	1.4
	48x72	2.4	1076	1.6
3K Baysaver Separator	60x60	7.2	3231	3.6
	60x72	7.2	3231	4.1
	60x84	7.2	3231	4.6
5K Baysaver Separator	72x72	11.1	4981	5.5
	72x84	11.1	4981	6.5
	72x96	11.1	4981	7.5
	96x96	11.1	4981	8.0

Project: CVS Designer: RIEMER MUEGGE  
 Address: WATERLOO RD Contact: CHRIS REID  
ELKRIE, MD. Phone: 410-997-8900  
21075 Fax: 410-997-9282  
 Delivery Date: \_\_\_\_\_  
 Owner: \_\_\_\_\_ Contractor: \_\_\_\_\_  
 Contact: \_\_\_\_\_ Address: \_\_\_\_\_  
 Address: \_\_\_\_\_ Phone: \_\_\_\_\_  
 Phone: \_\_\_\_\_ Fax: \_\_\_\_\_

Separator Unit Model:  
 1K ☐ ☐ ☐  
 3K ☐ ☐ ☐  
 5K ☐ ☐ ☐

Manhole Specifications:  
 Primary Manhole Diameter: 60 inches  
 Storage Manhole Diameter: 60 inches  
 Floor Elevations:  
 Primary Manhole 311.55  
 Storage Manhole 311.55  
 Primary Manhole Inverts:  
 Separator Unit 319.55  
 Inlet Pipe(s) 319.42  
 Cover Elevations:  
 Primary Manhole 324.95  
 Storage Manhole 315.0  
 Please show orientation (including angle), size and material of inlet pipes above.  
 Circle system orientation above  
 WQ-1/WQ-1A

This order can be faxed to Bay Saver, Inc. at (301) 829-3747

BAYSAYER SYSTEM DIMENSIONS				
DESCRIPTION	1K SYSTEM	3K SYSTEM	5K SYSTEM	
SEPARATOR MANHOLE DIMENSIONS				
A PRIMARY MANHOLE DIAMETER	48"	60"	72"	
B MANHOLE DEPTH BELOW OUTLET	8' - 0"	8' - 0"	8' - 0"	
C MINIMUM FLUID DEPTH	8' - 3"	8' - 4 1/2"	8' - 6"	
STANDARD SEPARATOR UNIT DIMENSIONS				
D SEPARATOR UNIT ID	24"	36"	48"	
E SEPARATOR UNIT LENGTH	60"	78.2"	75.4"	
F BYPASS PLATE LENGTH	34"	45"	45"	
G WEIR/BYPASS PLATE THICKNESS	3/4"	3/4"	3/4"	
H ELBOW AND CONNECTING PIPE OD	7.125"	10.75"	12.75"	
I ELBOW LENGTH	48"	48"	48"	
J WEIR HEIGHT ABOVE INVERT	3"	4"	6"	
K BYPASS PLATE HEIGHT ABOVE INVERT	12"	18"	24"	
L WIDTH OF WEIR AT BASE	3"	4 1/2"	6"	
M OUTLET PIPE DIAMETER	M	M	M	
N ELBOW INVERT HEIGHT ABOVE UNIT INVERT	4 1/2"	7 1/2"	11"	
O ELBOW PIPE OVERHANG	12"	18"	24"	
STORAGE MANHOLE DIMENSIONS				
P STORAGE MANHOLE DIAMETER	48"	60"	72"	
Q MANHOLE DEPTH BELOW INLET/OUTLET	48"	48"	48"	
R FLUID DEPTH	8' - 0"	8' - 0"	8' - 0"	
S TOTAL STORAGE VOLUME	200 CF	300 CF	450 CF	
SYSTEM DIMENSIONS AND ELEVATIONS				
T SEPARATOR MANHOLE COVER ELEVATION	T	T	T	
U STORAGE MANHOLE COVER ELEVATION	U	U	U	
V SEPARATOR MANHOLE FLOOR ELEVATION	V	V	V	
W STORAGE MANHOLE FLOOR ELEVATION	W	W	W	
X INLET PIPE ID AND MATERIAL	X1 X2	X1 X2	X1 X2	
Y INLET PIPE INVERT	Y1 Y2	Y1 Y2	Y1 Y2	
Z SEPARATOR UNIT INVERT	Z	Z	Z	
AA OUTLET PIPE ID AND MATERIAL	AA	AA	AA	
AB ELBOW INVERT ELEVATION	AB	AB	AB	
AC CONNECTING PIPE INVERT ELEVATION	AC	AC	AC	
AD CONNECTION PIPE SPACING	20"	24"	24"	
AE STORAGE MANHOLE SIDE OFFSET	72 ± 6"	72 ± 6"	72 ± 6"	
AF STORAGE MANHOLE DOWNSTREAM OFFSET	23"	31"	25"	

**AS-BUILT CERTIFICATE**  
 CHRISTOPHER J. REID #19949 DATE 9.12.00  
 APPROVED: FOR PUBLIC WATER AND PUBLIC SEWERAGE SYSTEMS, HOWARD COUNTY HEALTH DEPARTMENT.  
Diane Matuszek M.D. 11/9/99 DATE  
 COUNTY HEALTH OFFICER  
 APPROVED: HOWARD COUNTY DEPARTMENT OF PLANNING AND ZONING.  
Joe S. Rosta 11/15/99 DATE  
 DIRECTOR  
Chris Reid 11/14/99 DATE  
 CHIEF, DEVELOPMENT ENGINEERING DIVISION  
Cindy Hamlin 11/12/99 DATE  
 CHIEF, DIVISION OF LAND DEVELOPMENT  
 DATE NO. REVISION  
 OWNER AUDREY OMENS ETAL 1533 GLENEAGLE DR. JESSUP, MD 20794 (410) 799-4655  
 OWNER OM HOSPITALITY MANAGEMENT, INC. 6251 WASHINGTON BLVD. ELKRIE, MD 21075 (410) 379-5095  
 DEVELOPER ASTON PROPERTIES 6525 MORRISON BLVD., SUITE 300 CHARLOTTE, NC 28211 (704) 366-1337  
 PROJECT CVS RETAIL STORE  
 AREA Parcels 259 & 260 Tax Map 37 Block 14, 20 Zoned B-1, B-2 6th Election District Howard County, Maryland  
 TITLE WATER QUALITY NOTES AND DETAILS  
 RIEMER MUEGGE & ASSOCIATES INC. ENGINEERING • ENVIRONMENTAL SERVICES • PLANNING • SURVEYING 8818 Centre Park Drive, Columbia, MD 21045 tel 410.997.8800 fax 410.997.8282  
 DATE DESIGNED BY: C.J.R.  
 DRAWN BY: D.A.M.  
 PROJECT NO.: 98313 SDP7.DWG  
 DATE: OCTOBER 13, 1999  
 SCALE: AS SHOWN  
 DRAWING NO.: 7 OF 8  
 ARTHUR E. MUEGGE #8707

AS-BUILT 9/11/00 SDP-99-123



SCHEDULE 'B' - PARKING LOT INTERNAL LANDSCAPING	
PARKING LOT	1
NUMBER OF PARKING SPACES	52
NUMBER OF SHADE TREES/ISLANDS* REQUIRED (1/20 SPACES)	3
NUMBER OF TREES PROVIDED	2
SHADE TREES	20
SHRUBS (10:1 SUBSTITUTION)	3
NUMBER OF ISLANDS REQUIRED	3
NUMBER OF ISLANDS PROVIDED	3
* 200 SF PLANTING AREA / ISLAND	


#### SUBSTITUTION NOTES:

(20) EVERGREEN SHRUBS WERE SUBSTITUTED FOR (2) SHADE TREE

SCHEDULE 'A' - PERIMETER LANDSCAPE EDGE		ADJACENT TO ROADWAYS						
PERIMETER	LANDSCAPE TYPE	1	2	3	4	5	6	7
		B	E	B	E	C	C	C
LINEAR FEET OF ROADWAY FRONTAGE/ PERIMETER		± 165'	± 300'	± 188'	± 90'	± 140'	± 280'	± 25'
CREDIT FOR EXISTING VEGETATION (YES, NO, LINEAR FEET) (DESCRIBE BELOW IF NEEDED)		NO	NO	NO	NO	NO	NO	NO
CREDIT FOR WALL, FENCE OR BERM (YES, NO, LINEAR FEET) (DESCRIBE BELOW IF NEEDED)		NO	YES 300' ± 3' H X2 WALLS	NO	NO	NO	NO	NO
NUMBER OF PLANTS REQUIRED		± 1/50' = 4 ± 1/40' = 5	± 1/60' = 5 ± 1/10' = 30	± 1/50' = 4 ± 1/40' = 5	± 1/40' = 2 ± 1/4' = 23	± 1/40' = 4 ± 1/20' = 7	± 1/40' = 7 ± 1/20' = 14	± 1/40' = 1 ± 1/20' = 1
NUMBER OF PLANTS PROVIDED		5 3	- 60	3 4	2 23	4 40	8 60	- 20
SHADE TREES								
EVERGREEN TREES								
SHRUBS								

#### NOTES:

\* WALLS, HEDGES AND FENCES MAY BE CREDITED TOWARDS MEETING 100% OF THE REQUIRED LANDSCAPE PLANTING. [PAGE 24 OF THE HOWARD COUNTY LANDSCAPE MANUAL DATED JANUARY 4, 1998]

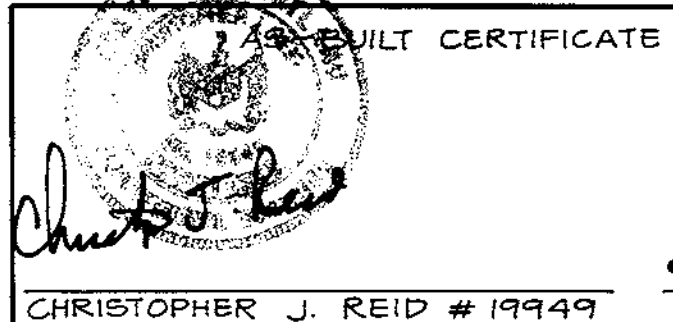

#### SUBSTITUTION NOTES:


PERIMETER 1:  
(3) FLOWERING TREES WERE SUBSTITUTED FOR (3) EVERGREEN TREES  
(1) SHADE TREE WAS SUBSTITUTED FOR (2) EVERGREEN TREES

PERIMETER 3:  
(4) FLOWERING TREES WERE SUBSTITUTED FOR (4) EVERGREEN TREES  
(10) SHRUBS WERE SUBSTITUTED FOR (1) SHADE TREE  
(12) SHRUBS WERE SUBSTITUTED FOR (1) EVERGREEN TREE

PERIMETER 5:  
(40) SHRUBS WERE SUBSTITUTED FOR (4) EVERGREEN TREES

PERIMETER 6:  
(1) SHADE TREE WAS SUBSTITUTED FOR (2) EVERGREEN TREES  
(60) SHRUBS WERE SUBSTITUTED FOR (6) EVERGREEN TREES

PERIMETER 7:  
(10) SHRUBS WERE SUBSTITUTED FOR (1) SHADE TREE  
(10) SHRUBS WERE SUBSTITUTED FOR (1) EVERGREEN TREE

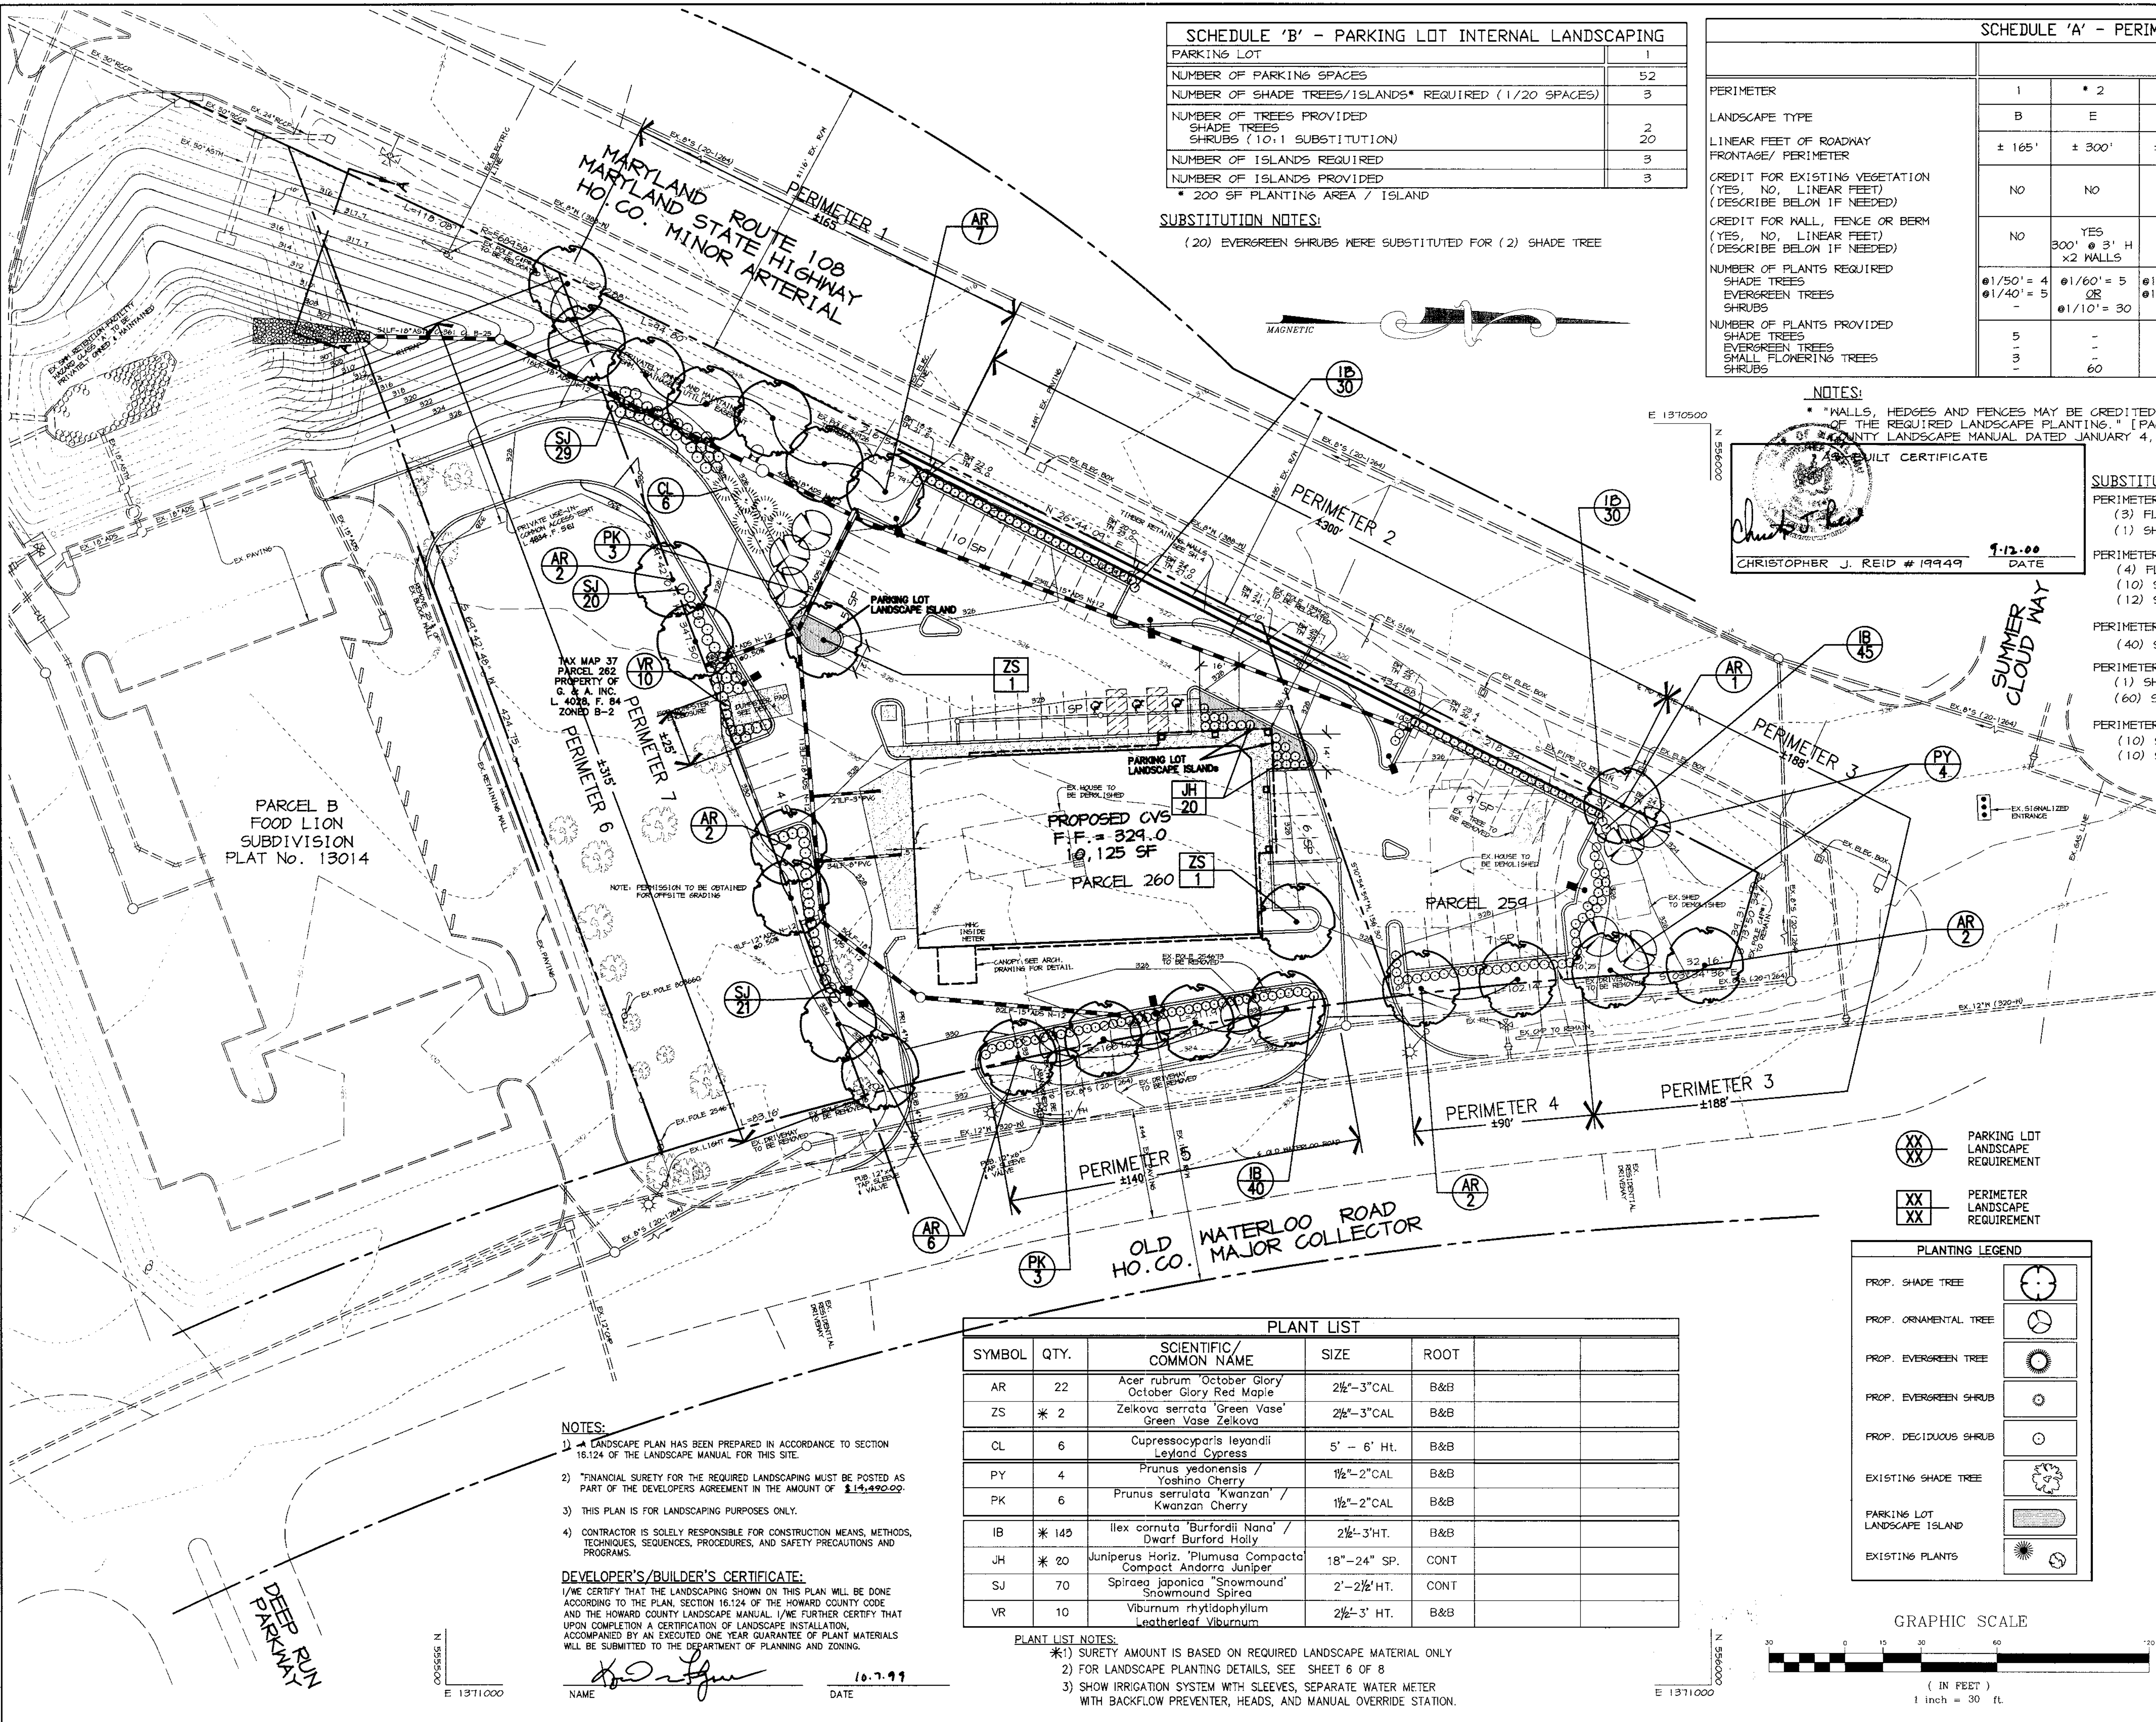

#### NOTES:

- LANDSCAPE PLAN HAS BEEN PREPARED IN ACCORDANCE TO SECTION 16.124 OF THE LANDSCAPE MANUAL FOR THIS SITE.
- "FINANCIAL SURETY FOR THE REQUIRED LANDSCAPING MUST BE POSTED AS PART OF THE DEVELOPER'S AGREEMENT IN THE AMOUNT OF \$14,490.00."
- THIS PLAN IS FOR LANDSCAPING PURPOSES ONLY.
- CONTRACTOR IS SOLELY RESPONSIBLE FOR CONSTRUCTION MEANS, METHODS, TECHNIQUES, SEQUENCES, PROCEDURES, AND SAFETY PRECAUTIONS AND PROGRAMS.

#### DEVELOPER'S/BUILDER'S CERTIFICATE:

I/WE CERTIFY THAT THE LANDSCAPING SHOWN ON THIS PLAN WILL BE DONE ACCORDING TO THE PLAN, SECTION 16.124 OF THE HOWARD COUNTY CODE AND THE HOWARD COUNTY LANDSCAPE MANUAL. I/WE FURTHER CERTIFY THAT UPON COMPLETION A CERTIFICATION OF LANDSCAPE INSTALLATION, ACCOMPANIED BY AN EXECUTED ONE YEAR GUARANTEE OF PLANT MATERIALS WILL BE SUBMITTED TO THE DEPARTMENT OF PLANNING AND ZONING.

NAME David T. Dows DATE 10.7.99

PLANT LIST					
SYMBOL	QTY.	SCIENTIFIC/COMMON NAME	SIZE	ROOT	
AR	22	Acer rubrum 'October Glory' / October Glory Red Maple	2 1/2" - 3" CAL	B&B	
ZS	* 2	Zeikova serrata 'Green Vase' / Green Vase Zeikova	2 1/2" - 3" CAL	B&B	
CL	6	Cupressocyparis leylandii / Leyland Cypress	5' - 6' HT.	B&B	
PY	4	Prunus yedoensis / Yoshino Cherry	1 1/2" - 2" CAL	B&B	
PK	6	Prunus serrulata 'Kwanzan' / Kwanzan Cherry	1 1/2" - 2" CAL	B&B	
IB	* 140	Ilex cornuta 'Burfordii Nano' / Dwarf Burford Holly	2 1/2" - 3" HT.	B&B	
JH	* 20	Juniperus Horiz. 'Plumosa Compacta' / Compact Andorra Juniper	18" - 24" SP.	CONT	
SJ	70	Spiraea japonica 'Snowmound' / Snowmound Spirea	2" - 2 1/2" HT.	CONT	
VR	10	Viburnum rhytiophyllum / Leatherleaf Viburnum	2 1/2" - 3" HT.	B&B	


#### PLANT LIST NOTES:

- SURETY AMOUNT IS BASED ON REQUIRED LANDSCAPE MATERIAL ONLY
- FOR LANDSCAPE PLANTING DETAILS, SEE SHEET 6 OF 8
- SHOW IRRIGATION SYSTEM WITH SLEEVES, SEPARATE WATER METER WITH BACKFLOW PREVENTER, HEADS, AND MANUAL OVERRIDE STATION.

XX XX  
XX XX  
XX XX

PLANTING LEGEND	
PROP. SHADE TREE	
PROP. ORNAMENTAL TREE	
PROP. EVERGREEN TREE	
PROP. EVERGREEN SHRUB	
PROP. DECIDUOUS SHRUB	
EXISTING SHADE TREE	
PARKING LOT LANDSCAPE ISLAND	
EXISTING PLANTS	

#### GRAPHIC SCALE

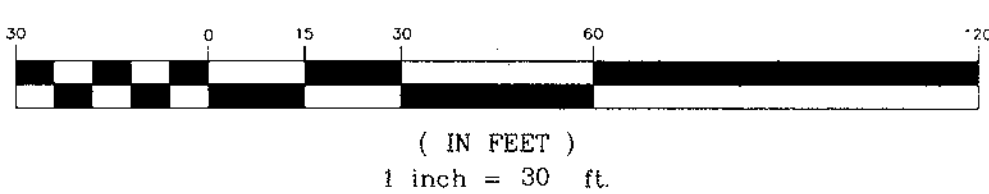

APPROVED: FOR PUBLIC WATER AND PUBLIC SEWERAGE SYSTEMS, HOWARD COUNTY HEALTH DEPARTMENT.

Dime Matsuyaka M.D. 11/9/99  
COUNTY HEALTH OFFICER DATE

APPROVED: HOWARD COUNTY DEPARTMENT OF PLANNING AND ZONING.

John Smith 11/15/99  
DIRECTOR DATE

Mike Pannunzi 11/4/99  
CHIEF, DEVELOPMENT ENGINEERING DIVISION DATE

Andy Henth 11/12/99  
CHIEF, DIVISION OF LAND DEVELOPMENT DATE

DATE NO. REVISION

OWNER: AUDREY OMENS ETAL 7533 GLENEAGLE DR. JESSUP, MD 20714 (410) 794-4655  
OWNER: OM HOSPITALITY MANAGEMENT, INC. 6251 WASHINGTON BLVD. ELKRIDGE, MD 21075 (410) 374-3045

DEVELOPER: ASTON PROPERTIES 6525 MORRISON BLVD., SUITE 300 CHARLOTTE, NC 28211 (704) 366-1331

PROJECT: CVS RETAIL STORE

AREA: Parcel: 254 & 260 Tax Map 37 Block 14, 20 Zoned B-1, B-2 6th Election District Howard County, Maryland

TITLE: LANDSCAPE PLAN

**RIEMER MUEGGE & ASSOCIATES INC.**  
ENGINEERING • ENVIRONMENTAL SERVICES • PLANNING • SURVEYING  
8818 Centre Park Drive, Columbia, MD 21045  
tel 410.997.8900 fax 410.997.9282

DATE: 8.6.99  
DESIGNED BY: D.T.D.  
DRAWN BY: A.L.  
PROJECT NO: 98313  
DATE: OCTOBER 13, 1999  
SCALE: 1" = 30'  
DRAWING NO. 8 OF 8

AS-BUILT 9/11/00 SDP-99-123